

STATE OF OREGON  
MONITORING WELL REPORT  
(as required by ORS 537.765 & OAR 690-240-095)

MAY 10 1993

WATER RESOURCES DEPT.

Start Card # 38289

(1) OWNER/PROJECT:

Name Chevron Chemical Co.  
Address 63149 Columbia River Hwy  
City St Helens State OR Zip 97051

(2) TYPE OF WORK:


☒ New construction ☐ Repair ☐ Recondition  
☐ Conversion ☐ Deepening ☐ Abandonment

(3) DRILLING METHOD

☐ Rotary Air ☐ Rotary Mud ☐ Cable  
☐ Hollow Stem Auger ☒ Other Recession Hammer Air

(4) BORE HOLE CONSTRUCTION

Special Standards ☐ Yes ☐ No Depth of completed well 93 ft.

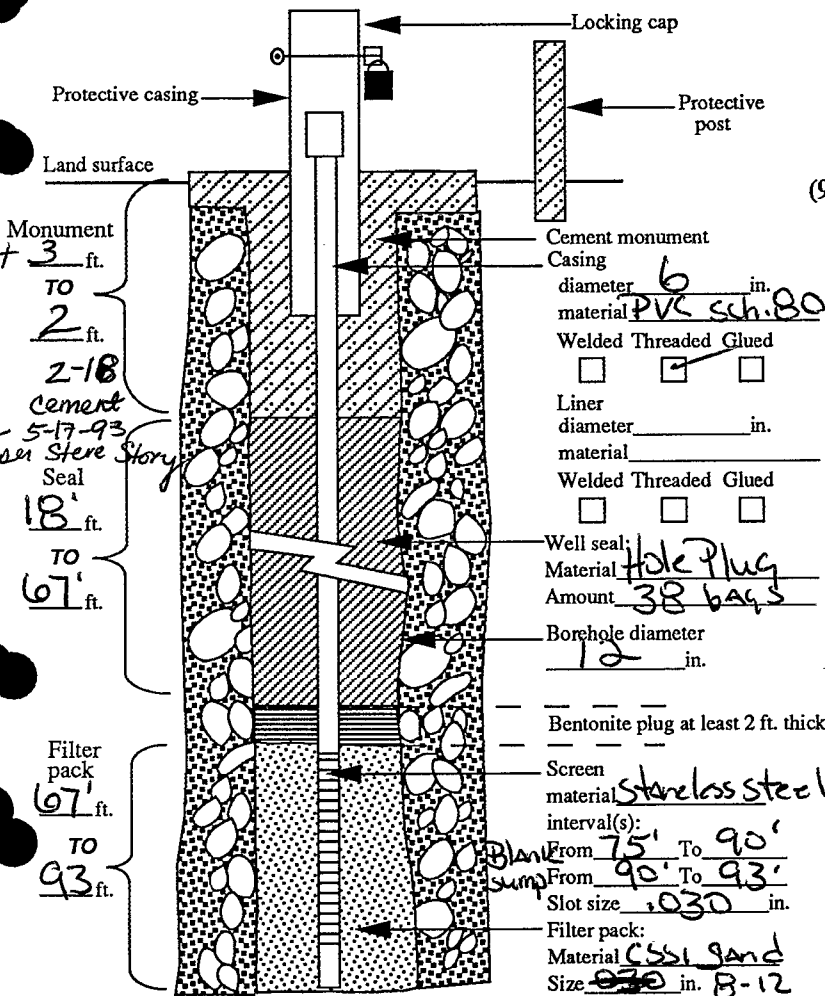

(5) WELL TEST:

☐ Pump ☐ Bailer ☐ Air ☐ Flowing Artesian

Permeability \_\_\_\_\_ Yield \_\_\_\_\_ GPM

Conductivity \_\_\_\_\_ PH \_\_\_\_\_

Temperature of water 12.8 °F/C Depth artesian flow found \_\_\_\_\_ ft.

Was water analysis done? ☐ Yes ☐ No

By whom? \_\_\_\_\_

Depth of strata to be analyzed. From \_\_\_\_\_ ft. to \_\_\_\_\_ ft.

Remarks: \_\_\_\_\_

Name of supervising Geologist/Engineer CALEN DAVIS

(6) LOCATION OF WELL By legal description

Well Location: County Columbia  
Township 5 (N or S) Range 1 (E or W) Section 17  
1. SE 1/4 of SE 1/4 of above section.  
2. Street address of well location 63149 Columbia River Hwy  
3. Tax lot number of well location 2-08511700000203  
4. ATTACH MAP WITH LOCATION IDENTIFIED.

(7) STATIC WATER LEVEL:

68 Ft. below land surface. Date 4-5-93  
Artesian Pressure \_\_\_\_\_ lb/sq. in. Date \_\_\_\_\_

(8) WATER BEARING ZONES:

Depth at which water was first found \_\_\_\_\_

| From | To | Est. Flow Rate | SWL |
|------|----|----------------|-----|
|      |    |                |     |
|      |    |                |     |
|      |    |                |     |
|      |    |                |     |

(9) WELL LOG:

Ground elevation \_\_\_\_\_

| Material                                                           | From | To  | SWL |
|--------------------------------------------------------------------|------|-----|-----|
| Red-brown silty fine sand - moist                                  | 0    | 5'  |     |
| Silty med to coarse gravel, little cobbles                         | 5'   | 7'  |     |
| Sandy, fine to med. gravel (basalt rounded)                        | 7'   | 24' |     |
| Silty coarse sand med. gravel gray rounded moist, to wet some clay | 24'  | 65' |     |
| Silty coarse sand medium gravel angular with some cobbles          | 65'  | 73' |     |
| brown damp silty sandy fine to med. gravel                         | 73'  | 83' |     |
| gray silty sandy med. rounded gravel                               | 83'  | 93' |     |

Date started 4-5-93 Completed 4-6-93

(unbonded) Monitor Well Constructor Certification:

I certify that the work I performed on the construction, alteration, or abandonment of this well is in compliance with Oregon well construction standards. Materials used and information reported above are true to the best knowledge and belief.

Signed [Signature] MWC Number 10205  
Date 4-19-93

(bonded) Monitor Well Constructor Certification:

I accept responsibility for the construction, alteration, or abandonment work performed on this well during the construction dates reported above. All work performed during this time is in compliance with Oregon well construction standards. This report is true to the best of my knowledge and belief.

Signed [Signature] MWC Number 10093  
Date 5/3/93

RECEIVED

MAY 10 1993

WATER RESOURCES DEPT.  
SALEM, OREGON

6

LEVEE

Beacon

17 COUNTY FAIRGROUNDS

BM 69

16

Pw2

Cem

Tanks

40

Maple Hill

Waterview

BM 77

BM 79

20

600

600

200

100

30

18

10

8

700  
500  
300



Oregon Water Resources Department  
725 Summer Street NE, Suite A  
Salem Oregon 97301  
(503) 986-0900  
www.oregon.gov/owrd

# Application for Well ID Number

**Do not complete if the well already has a Well Identification Number.**

RECEIVED

AUG 15 2023

## I. OWNER INFORMATION

OWRD

Current Owner Name (please print): Dyno Nobel, Inc.

Mailing Address: 63149 Columbia River Hwy.

City, State, Zip: Deer Island, Oregon 97054

Mail Well ID to: ☒ SAME AS ABOVE ☒ In Care Of (C/O)

Name & Address: Fran Erickson 63149 Columbia River Hwy

City, State, Zip: Deer Island, Oregon 97054

## II. WELL LOCATION INFORMATION (Please fill out as completely as possible)

Township: 5 (North / South) Range: 1 (East / West) Section: 17 SW 1/4 of the SE 1/4

Tax Lot (usually last 3-5 numbers of Tax Map #): 203 County Columbia

GPS Coordinates: 45.91305211 -122.82942

Street Address of Well, City: 63201 Columbia River Highway, Deer Island

If the property had a different street address in the past: Site Specific Well ID = PW-2

## III. GENERAL WELL INFORMATION (Please fill out as completely as possible, AND attach copy of Well Report, if available)

Use of Well (domestic, irrigation, commercial, industrial, monitoring): Industrial

Date Well Constructed (or property built): 4/5/1993 Total Well Depth: 92.9 ft Casing Diameter: 6 Inches

Owner at time the well was constructed (if known): Chevron Chemical Co. Well Report # (if known): COLU 664

Other Information: NA

SUBMITTED BY (please print): Fran Erickson

PHONE: 503-366-8902

EMAIL &/or FAX: Fran.Erickson@Am.DynoNobel.com

To send the completed application, you may MAIL it to: Oregon Water Resources Dept. 725 Summer St NE, Suite A, Salem, Oregon 97301.  
Or EMAIL the completed PDF form to: Ladeena.K.Ashley@water.oregon.gov, or FAX it to: (503) 986-0902.

For Official Use Only by the Oregon Water Resources Department:

Received Date:

8-15-2023

Well Report Number:

COLU 664

Well Identification #:

L-152826