

STATE ENGINEER
Salem, Oregon

Coos Well Record

STATE WELL NO. 28/14W-28H
COUNTY Coos
APPLICATION NO. CR-3414


003922

OWNER: C. F. St. Sur MAILING ADDRESS: Route 1, Box 68

LOCATION OF WELL: Owner's No. _____ CITY AND STATE: Bandon, Oregon

SE 1/4 NE 1/4 Sec. 28 T. 28 S., R. 14 W., W.M.

Bearing and distance from section or subdivision corner 800 ft. W. of SE corner NE 1/4 Sec. 28

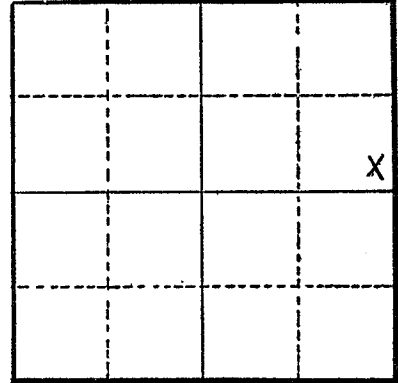

Section 28

Altitude at well _____

TYPE OF WELL: Dug Date Constructed July, 1936

Depth drilled 8 ft. Depth cased _____

CASING RECORD:

FINISH:

AQUIFERS:

WATER LEVEL:

4 feet below surface

PUMPING EQUIPMENT: Type Piston pump - household type H.P. 1/4
Capacity 5 G.P.M.

WELL TESTS:

Drawdown _____ ft. after _____ hours 425 G.P.M.
Drawdown _____ ft. after _____ hours _____ G.P.M.

USE OF WATER Irrigation Temp. _____ °F., 19

SOURCE OF INFORMATION Well Registration Statement

DRILLER or DIGGER _____

ADDITIONAL DATA:

Log X Water Level Measurements _____ Chemical Analysis _____ Aquifer Test _____

REMARKS:

Log:
Sand