

STATE ENGINEER  
Salem, Oregon

Well Record **9008**  
STATE WELL NO 28/14W-29D(1)  
COUNTY Coos  
APPLICATION NO. GR-793  
**003954**

OWNER: Ray W. Bates  
MAILING ADDRESS: Box 574  
CITY AND STATE: Bandon, Oregon


LOCATION OF WELL: Owner's No. #1  
N. E.  
NW 1/4 NW 1/4 Sec. 29 T. 28 S., R. 14 W., W.M.

Bearing and distance from section or subdivision  
corner 750' E & 740' S from NW cor. of Sec. 29

Altitude at well 60'

TYPE OF WELL: Dug Date Constructed 1936

Depth drilled 18' Depth cased 18'

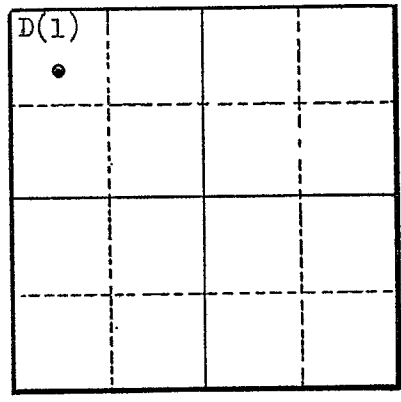

Section 29

CASING RECORD:

36-inch concrete pipe

FINISH:

AQUIFERS:

WATER LEVEL:

flowing

PUMPING EQUIPMENT: Type Cent. pump H.P. 1/2  
Capacity 20 G.P.M.

WELL TESTS:

Drawdown \_\_\_\_\_ ft. after \_\_\_\_\_ hours \_\_\_\_\_ G.P.M.  
Drawdown \_\_\_\_\_ ft. after \_\_\_\_\_ hours \_\_\_\_\_ G.P.M.

USE OF WATER Irrigation Temp. \_\_\_\_\_ °F. \_\_\_\_\_, 19\_\_\_\_

SOURCE OF INFORMATION GR-793

DRILLER or DIGGER Owner

ADDITIONAL DATA:

Log Below Water Level Measurements \_\_\_\_\_ Chemical Analysis \_\_\_\_\_ Aquifer Test \_\_\_\_\_

REMARKS:

Sand 0 - 18'