

STATE ENGINEER
Salem, Oregon

Well Record

STATE WELL NO. 28/14W-29D(2)
COUNTY Coos
APPLICATION NO. GR-794

003955

OWNER: Ray W. Bates


MAILING ADDRESS: B6x 574

LOCATION OF WELL: Owner's No. #2

CITY AND STATE: Bandon, Oregon

NW 1/4 NW 1/4 Sec. 29 T. 28 N. S., R. 14 W., W.M.

Bearing and distance from section or subdivision
corner 1000' E & 475' S from the NW cor.
of Sec. 29

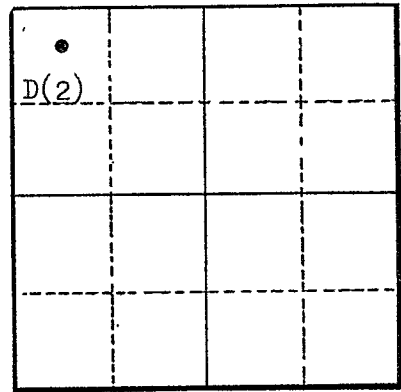

Section 29

Altitude at well 102'

TYPE OF WELL: Dug Date Constructed 1932
Depth drilled 25' Depth cased unknown

CASING RECORD:

unknown

FINISH:

AQUIFERS:

WATER LEVEL:

1 foot

PUMPING EQUIPMENT: Type Elect. cent. H.P. 15
Capacity 450 G.P.M.

WELL TESTS:

Drawdown ft. after hours G.P.M.
Drawdown ft. after hours G.P.M.

USE OF WATER Irrigation Temp. °F., 19

SOURCE OF INFORMATION GR-794

DRILLER or DIGGER

ADDITIONAL DATA:
Log None Water Level Measurements Chemical Analysis Aquifer Test

REMARKS: