

27-14-29

STATE OF OREGON
WATER SUPPLY WELL REPORT

(as required by ORS 537.765)

WELL I.D. # L 34018

START CARD # 123851

Instructions for completing this report are on the last page of this form.

(1) OWNER: Well Number 716
Name Bandon Dunes Golf Course
Address Round Lake Drive 57741
City Bandon State OR Zip 97411

(2) TYPE OF WORK Conversion
 New Well Deepening Alteration (repair/recondition) Abandonment

(3) DRILL METHOD:
 Rotary Air Rotary Mud Cable Auger
 Other

(4) PROPOSED USE:
 Domestic Community Industrial Irrigation
 Thermal Injection Livestock Other

(5) BORE HOLE CONSTRUCTION:
Special Construction approval Yes No Depth of Completed Well 88'2"
Explosives used Yes No Type _____ Amount _____

HOLE		SEAL		Sacks or pounds	
Diameter	From To	Material	From To		
14"	0 30	Bentonite	0 35		48 SX
12 1/4"	40 88				
6"	88 155	Cement	90 155		10 SX
(Previously installed)					

How was seal placed: Method A B C D E
 Other _____

Backfill placed from _____ ft. to _____ ft. Material _____
Gravel placed from 40 ft. to 88 ft. Size of gravel 6/9

(6) CASING/LINER:

Diameter	From To	Gauge	Steel	Plastic	Welded	Threaded
Casing: 8"	+1 62 1/2"	1.250	<input checked="" type="checkbox"/>	<input type="checkbox"/>	<input checked="" type="checkbox"/>	<input type="checkbox"/>
8"	78 2 1/2"	1.882	<input checked="" type="checkbox"/>	<input type="checkbox"/>	<input checked="" type="checkbox"/>	<input type="checkbox"/>
(Tail Pipe)						
Liner:			<input type="checkbox"/>	<input type="checkbox"/>	<input type="checkbox"/>	<input type="checkbox"/>

Final location of shoe(s) _____

(7) PERFORATIONS/SCREENS:

Perforations Method Attached to casing
 Screens Type Johnson V-wire Material SS

From	To	Slot size	Number	Diameter	Tele/pipe size	Casing	Liner
62 1/2"	78 2 1/2"	.075		8"	PIPE	<input type="checkbox"/>	<input type="checkbox"/>

(8) WELL TESTS: Minimum testing time is 1 hour

<input checked="" type="checkbox"/> Pump	<input type="checkbox"/> Bailer	<input type="checkbox"/> Air	<input type="checkbox"/> Flowing
Yield gal/min	Drawdown	Drill stem at	Time
135	25'	69'	1 hr.
132	29	69	21.75 hrs

Temperature of water 53° Depth Artesian Flow Found _____

Was a water analysis done? Yes By whom _____

Did any strata contain water not suitable for intended use? Too little

Salty Muddy Odor Colored Other

Depth of strata: _____

Bandon Well & Septic Co., Inc.

(9) LOCATION OF WELL by legal description:
County CS Latitude _____ Longitude _____
Township 27 N or (S) Range 14 E or (W) W.M.
Section 29 NE 1/4 NW 1/4
Tax Lot 400 Lot _____ Block _____ Subdivision _____
Street Address of Well (or nearest address) 57741 Round Lake Drive Bandon

(10) STATIC WATER LEVEL:
34'8" ft. below land surface. Date 11/10/01
Artesian pressure _____ lb. per square inch. Date _____

(11) WATER BEARING ZONES:
Depth at which water was first found 34'8"

From	To	Estimated Flow Rate	SWL
76		130	34'8"
NOV 10 2001			

WATER RESOURCES DEPT.
SALEM, OREGON

(12) GROUND ELEVATION +1-300'

Material	From	To	SWL
Sand Fine Brown	0	1	
Sand Fine orange brown	1	8	
Peat w/sand Fine brown	8	10	
Sand Fine brown	10	17	
Sandy Clay white	17	19	
Sand Fine-med brown	19	40	34'8"
Sand Fine-med Gray brown	40	50	
Gravel Fine-med w/sand	50	55	
CRS-Fine Gray			
Gravel Fine-CRS w/sand	55	70	
CRS-Fine Gray brown			
Gravel Fine-med w/sand	70	76	
CRS-Fine brown			
Clay Gray Green	76	89	

Hole originally geo Tech hole drilled to 155'. 8" Pipe casing removed and hole opened to accommodate 8" production well

Date started 11/6/01 Completed 11/12/01

(unbonded) Water Well Constructor Certification:

I certify that the work I performed on the construction, alteration, or abandonment of this well is in compliance with Oregon water supply well construction standards. Materials used and information reported above are true to the best of my knowledge and belief.

Signed Chris Kasey WWC Number 1759 Date 11-12-01

(bonded) Water Well Constructor Certification:

I accept responsibility for the construction, alteration, or abandonment work performed on this well during the construction dates reported above. All work performed during this time is in compliance with Oregon water supply well construction standards. This report is true to the best of my knowledge and belief.

Signed Jim Mackin M.G.W.C. WWC Number 1493 Date 11/12/01

...RANGE 13 W.W.M. ...NTY ORE.

Reproduction in whole
or part for personal use or
resale is prohibited by law.


ENGLEWOOD

To Coos Bay ↗



weir

To Eastside ↘

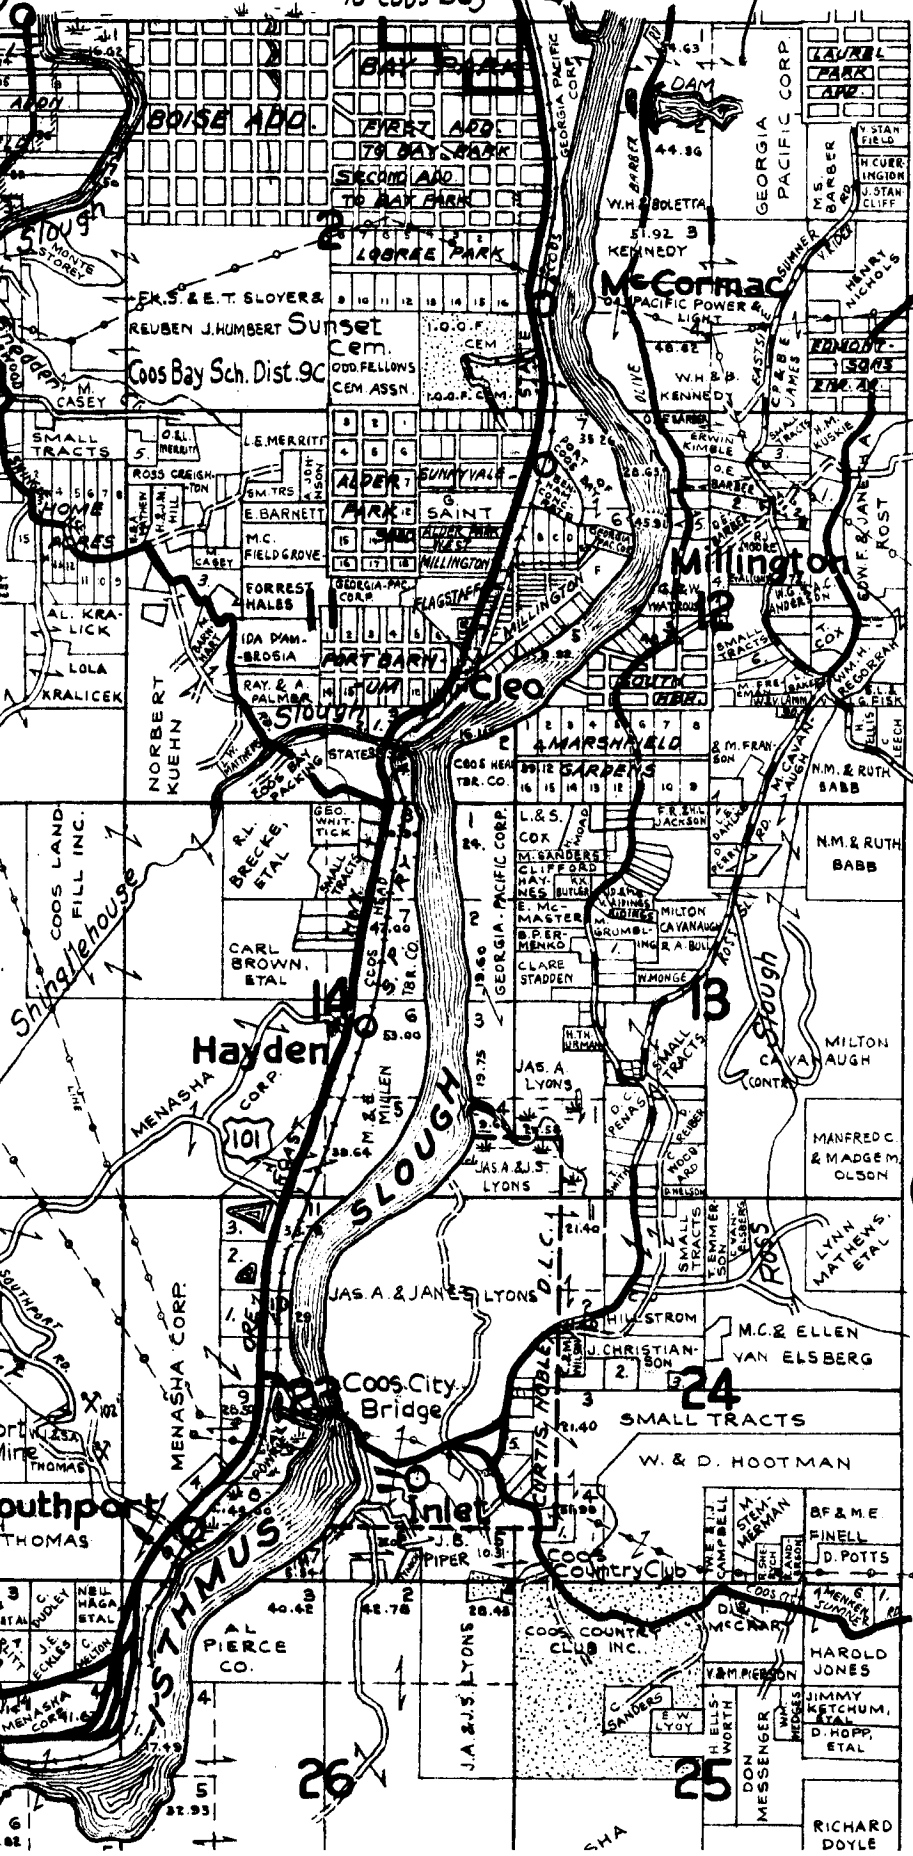

SMALL TRACTS

- SEC. 3
 1. RICHARD STROBERT
 2. PACIFIC POWER & LIGHT CO.
- SEC. 11
 1. DANIEL KIRKPATRICK
 2. R.L. MATTHEWS
 3. JOHN GUIMON, ETAL
 4. GEORGIA PACIFIC CORP.
 5. MERLE E. RADA
- SEC. 12
 1. SMITH JENSEN, INC.
 2. G. SUTHERLAND
 3. G. & B. FULLERTON
 4. M. & M. WATRODS
 5. RICHARD D. DOLNEY
 6. J. T. SHEPHERD
- SEC. 13
 1. ROBERT A. MCMANIMAN
- SEC. 23
 1. SMITH JENSEN, INC.
 2. CRESCENT CITY MARINE WAYS & DRY DOCK INC.
 3. JOHN E. HANSON, JR.
 4. SIXES RIVER LOGGING
 5. F. & B. MUENCH
- SEC. 24
 1. BEVERLY PEMBERTON
 2. LAWTON CHAMBERS
 3. LOYAL C. JOHNSON
- SEC. 25
 1. F. CELORIE
- SEC. 26
 1. GEORGIA PACIFIC CORP.
- SEC. 27
 1. HAROLD R. SMITH

RECEIVED

NOV 16 2001

WATER RESOURCES DEPT.
SALEM, OREGON

32