

STATE OF OREGON
WATER SUPPLY WELL REPORT
(as required by ORS 537.765 & OAR 690-205-0210)

11-12-2010

WELL LABEL # 02403 97408
START CARD # 1012087

(1) LAND OWNER Owner Well I.D. 1366
First Name Audrey Last Name Bailey
Company _____
Address 89010 Hwy 42S, Unit #9
City Bandon State OR Zip 97411

(2) TYPE OF WORK New Well Deepening Conversion
 Alteration (repair/recondition) Abandonment

(3) DRILL METHOD
 Rotary Air Rotary Mud Cable Auger Cable Mud
 Reverse Rotary Other _____

(4) PROPOSED USE Domestic Irrigation Community
 Industrial/ Commercial Livestock Dewatering
 Thermal Injection Other _____

(5) BORE HOLE CONSTRUCTION Special Standard Attach copy
Depth of Completed Well 58.00 ft.

BORE HOLE			SEAL			Amt	sacks/ lbs
Dia	From	To	Material	From	To		
18	0	3	Bentonite	0	3	5	S
10	3	58	Bentonite	3	45	28	S

How was seal placed Method A B C D E
 Other Pour from surface
Backfill placed from _____ ft to _____ ft. Material _____
Filter pack from 45 ft to 58 ft Material Sand Size 10/20
Explosives used Yes Type _____ Amount _____

(6) CASING/LINER

Casing	Liner	Dia	+	From	To	Gauge	Stl	Pstc	Wld	Thrd
<input checked="" type="checkbox"/>	<input checked="" type="checkbox"/>	5	X	1	53	Sdr21	<input checked="" type="checkbox"/>	<input checked="" type="checkbox"/>	<input checked="" type="checkbox"/>	<input type="checkbox"/>
<input type="checkbox"/>	<input type="checkbox"/>	6	X	1.5	4	250	<input type="checkbox"/>	<input type="checkbox"/>	<input type="checkbox"/>	<input type="checkbox"/>

Shoe Inside Outside Other Location of shoe(s) _____
Temp casing Yes Dia _____ From _____ To _____

(7) PERFORATIONS/SCREENS

Perforations Method _____
Screens Type Johnson V-Wyre Material Stainless Steel

Perf/S	Casing/Screen	Liner	Dia	From	To	Scr/slot width	Slot length	# of slots	Tele/ pipe size
Screen			5	53	58	021			5

(8) WELL TESTS: Minimum testing time is 1 hour

Pump Bailor Air Flowing Artesian

Yield gal/min	Drawdown	Drill stem/Pump depth	Duration (hr)
6.2	21	57	

Temperature 54 °F Lab analysis Yes By Bandon Well & Pump Co
Water quality concerns? Yes (describe below)

From	To	Description	Amount	Units

(9) LOCATION OF WELL (legal description)
County Coos Twp 28.00 S N/S Range 14.00 W E/W WM
Sec 21 SW 1/4 of the SE 1/4 Tax Lot 700
Tax Map Number _____ Lot _____
Lat _____ or _____ DMS or DD
Long _____ or _____ DMS or DD
 Street address of well Nearest address

88010 Hwy 42S, Unit #9, Bandon

(10) STATIC WATER LEVEL

Existing Well / Predeepening	Date	SWL (psi)	+ SWL (ft)
Completed Well	11-11-2010		31.8

Flowing Artesian? Dry Hole?

WATER BEARING ZONES Depth water was first found 41

SWL Date	From	To	Est Flow	SWL (psi)	+ SWL (ft)
11-10-2010	41	57	6.2		31.75

(11) WELL LOG Ground Elevation 500

Material	From	To
Topsoil	0	1
Gravel c-f	1	3
Sand f-m dark brown	3	12
Sand f-m brown	12	16
Sandy clay w/ sand f-m tan	16	18
Sand f-m w/sandy clay brown	18	25
Sand f-m brown	25	30
Sandy clay w/gravel f tan	30	37
Peat w/clay dk brown	37	41
Sand f-m w/sandy clay brown	41	44
Wood (soft) w/sand f-m brown	44	54
Gravel fine w/sand c-f brown & sandy clay 10%	54	57
Clay blue gray	57	58

Date Started 11-09-2010 Completed 11-11-2010

(unbonded) Water Well Constructor Certification
I certify that the work I performed on the construction, deepening, alteration, or abandonment of this well is in compliance with Oregon water supply well construction standards. Materials used and information reported above are true to the best of my knowledge and belief.


License Number _____ Date _____
Electronically Filed
Signed _____

(bonded) Water Well Constructor Certification
I accept responsibility for the construction, deepening, alteration, or abandonment work performed on this well during the construction dates reported above. All work performed during this time is in compliance with Oregon water supply well construction standards. This report is true to the best of my knowledge and belief.

License Number 1491 Date 11-12-2010
Electronically Filed
Signed JAMES A MACK SR (E-filed)
Contact Info (optional) Bandon Well & Pump Co. (541) 347-7867

Property owner owns This Lot
28-14-28 AB TL300 Bear Creek
Apartments Canyon

Existing Spring
Water System

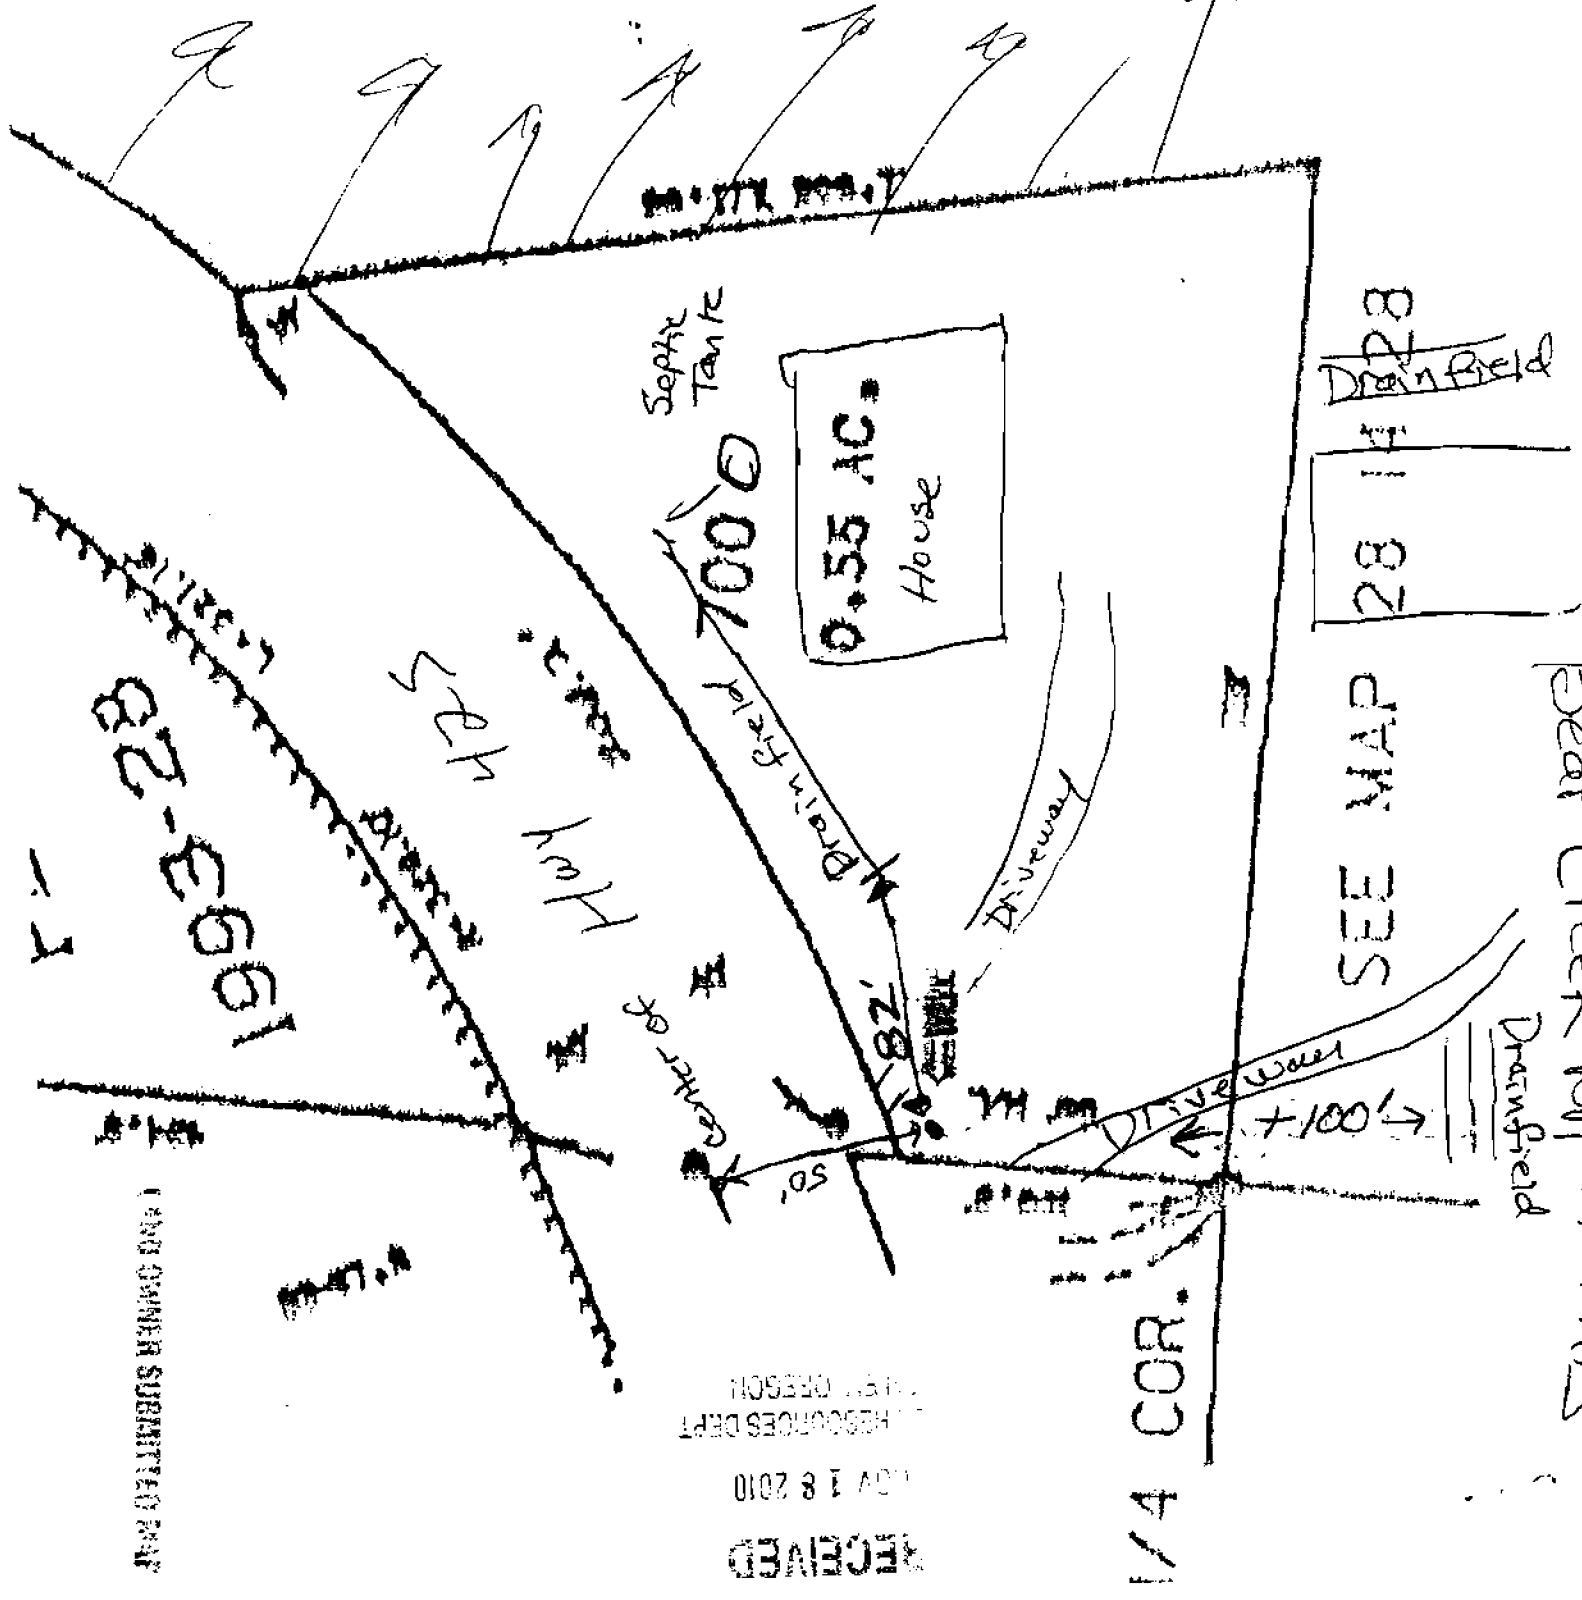

Bear Creek Apartments

28-14-28
Drain Field

SEE MAP

Drain Field

RECEIVED
NOV 18 2010
REGISTRARS DEPT
1993-28

LAND OWNER SUBMITTED PLAN