

STATE OF OREGON
WATER SUPPLY WELL REPORT
(as required by ORS 537.765 & OAR 690-205-0210)

COOS 57571

8/7/2019

WELL I.D. LABEL# L 129836
START CARD # 1043998
ORIGINAL LOG # COOS 57371

(1) LAND OWNER
Owner Well I.D. 1744-SR2 / 1809
First Name MICHAEL Last Name KEISER
Company BALLY BANDON LLC
Address 875 N MICHIGAN AVE #3920
City CHICAGO State IL Zip 60611

(2) TYPE OF WORK
New Well Deepening Conversion
Alteration (complete 2a & 10) Abandonment(complete 5a)

(2a) PRE-ALTERATION
Dia + From To Gauge Stl Plstc Wld Thrd
Casing: 6 6 14 .250
Material From To Amt sacks/lbs
Seal: Bentonite 0 14 9 Sacks

(3) DRILL METHOD
Rotary Air Rotary Mud Cable Auger Cable Mud
Reverse Rotary Other

(4) PROPOSED USE
Domestic Irrigation Community
Industrial/ Commercial Livestock Dewatering
Thermal Injection Other

(5) BORE HOLE CONSTRUCTION
Special Standard (Attach copy)
Depth of Completed Well 72.66 ft.

Table with columns: Dia, From, To, Material, From, To, Amt, sacks/lbs. Includes data for Bentonite and Calculated values.

How was seal placed: Method A B C D E
Other POUR FROM SURFACE

Backfill placed from ft. to ft. Material
Filter pack from 28 ft. to 74 ft. Material SAND Size 8/12

Explosives used: Yes Type Amount

(5a) ABANDONMENT USING UNHYDRATED BENTONITE
Proposed Amount Actual Amount

(6) CASING/LINER
Casing Liner Dia + From To Gauge Stl Plstc Wld Thrd
Shoe Inside Outside Other Location of shoe(s)
Temp casing Yes Dia From + To

(7) PERFORATIONS/SCREENS
Perforations Method
Screens Type Johnson V-Wire Material Stainless Steel
Perf/ Casing/ Screen Dia From To Scrn/slot Slot # of Tele/
Screen Liner Dia From To width length slots pipe size

(8) WELL TESTS: Minimum testing time is 1 hour
Pump Bailer Air Flowing Artesian

Table with columns: Yield gal/min, Drawdown, Drill stem/Pump depth, Duration (hr). Includes data for 51.3, 9.2, 63, 1.

Temperature 53 °F Lab analysis Yes By
Water quality concerns? Yes (describe below) TDS amount 114 ppm

Table with columns: From, To, Description, Amount, Units.

(9) LOCATION OF WELL (legal description)
County coos Twp 27.00 S N/S Range 14.00 W E/W WM
Sec 20 SW 1/4 of the NW 1/4 Tax Lot 100
Tax Map Number Lot
Lat " or 43.21992550 DMS or DD
Long " or -124.39089620 DMS or DD
Street address of well Nearest address
NO# WHISKEY RUN RD, BANDON

(10) STATIC WATER LEVEL
Date SWL(psi) + SWL(ft)
Existing Well / Pre-Alteration
Completed Well 7/27/2019 40
Flowing Artesian? Dry Hole?

Table with columns: SWL Date, From, To, Est Flow, SWL(psi), + SWL(ft). Includes data for 7/26/2019, 40, 65, 50, 40.

(11) WELL LOG
Ground Elevation 128.00

Table with columns: Material, From, To. Lists various soil types and depths from 0 to 73 feet.

Date Started 7/25/2019 Completed 7/27/2019

(unbonded) Water Well Constructor Certification
I certify that the work I performed on the construction, deepening, alteration, or abandonment of this well is in compliance with Oregon water supply well construction standards. Materials used and information reported above are true to the best of my knowledge and belief.
License Number Date
Signed

(bonded) Water Well Constructor Certification
I accept responsibility for the construction, deepening, alteration, or abandonment work performed on this well during the construction dates reported above. All work performed during this time is in compliance with Oregon water supply well construction standards. This report is true to the best of my knowledge and belief.
License Number 1493 Date 8/7/2019
Signed JAMES MACK SR (E-filed)
Contact Info (optional) Bandon Well & Pump Co (541) 347-7867

**WATER SUPPLY WELL REPORT - continuation page**

**COOS 57571**

**WELL I.D. LABEL# L129836**

**START CARD # 1043998**

**8/7/2019**

**ORIGINAL LOG # COOS 57371**

**(2a) PRE-ALTERATION**

Dia	+	From	To	Gauge	Stl	Plstc	Wld	Thrd
Material		From	To	Amt	sacks/lbs			

**(5) BORE HOLE CONSTRUCTION**

BORE HOLE			Material	SEAL		Amt	sacks/lbs
Dia	From	To		From	To		
						Calculated	
						Calculated	
						Calculated	
						Calculated	

**FILTER PACK**

From	To	Material	Size

**(6) CASING/LINER**

Casing Liner	Dia	+	From	To	Gauge	Stl	Plstc	Wld	Thrd

**(7) PERFORATIONS/SCREENS**

Perf/ Screen	Casing/ Liner Dia	Screen Dia	From	To	Scrn/slot width	Slot length	# of slots	Tele/ pipe size

**(8) WELL TESTS: Minimum testing time is 1 hour**

Yield gal/min	Drawdown	Drill stem/Pump depth	Duration (hr)

**Water Quality Concerns**

From	To	Description	Amount	Units

**(10) STATIC WATER LEVEL**

SWL Date	From	To	Est Flow	SWL(psi)	+ SWL(ft)

**(11) WELL LOG**

Material	From	To

**Comments/Remarks**


Original test well had ground elevation lowered 5'. 6" steel casing was removed and 10" hole was drilled to 73' where well was completed. Well is completed below ground level in a 48" x 36" concrete vault with a 24" water tight manhole approved special standard. Well is in the middle of a fairway on golf course.

WATER SUPPLY WELL REPORT - Map with location identified must be attached and shall include an approximate scale and north arrow

COOS 57571

8/7/2019

Map of Hole

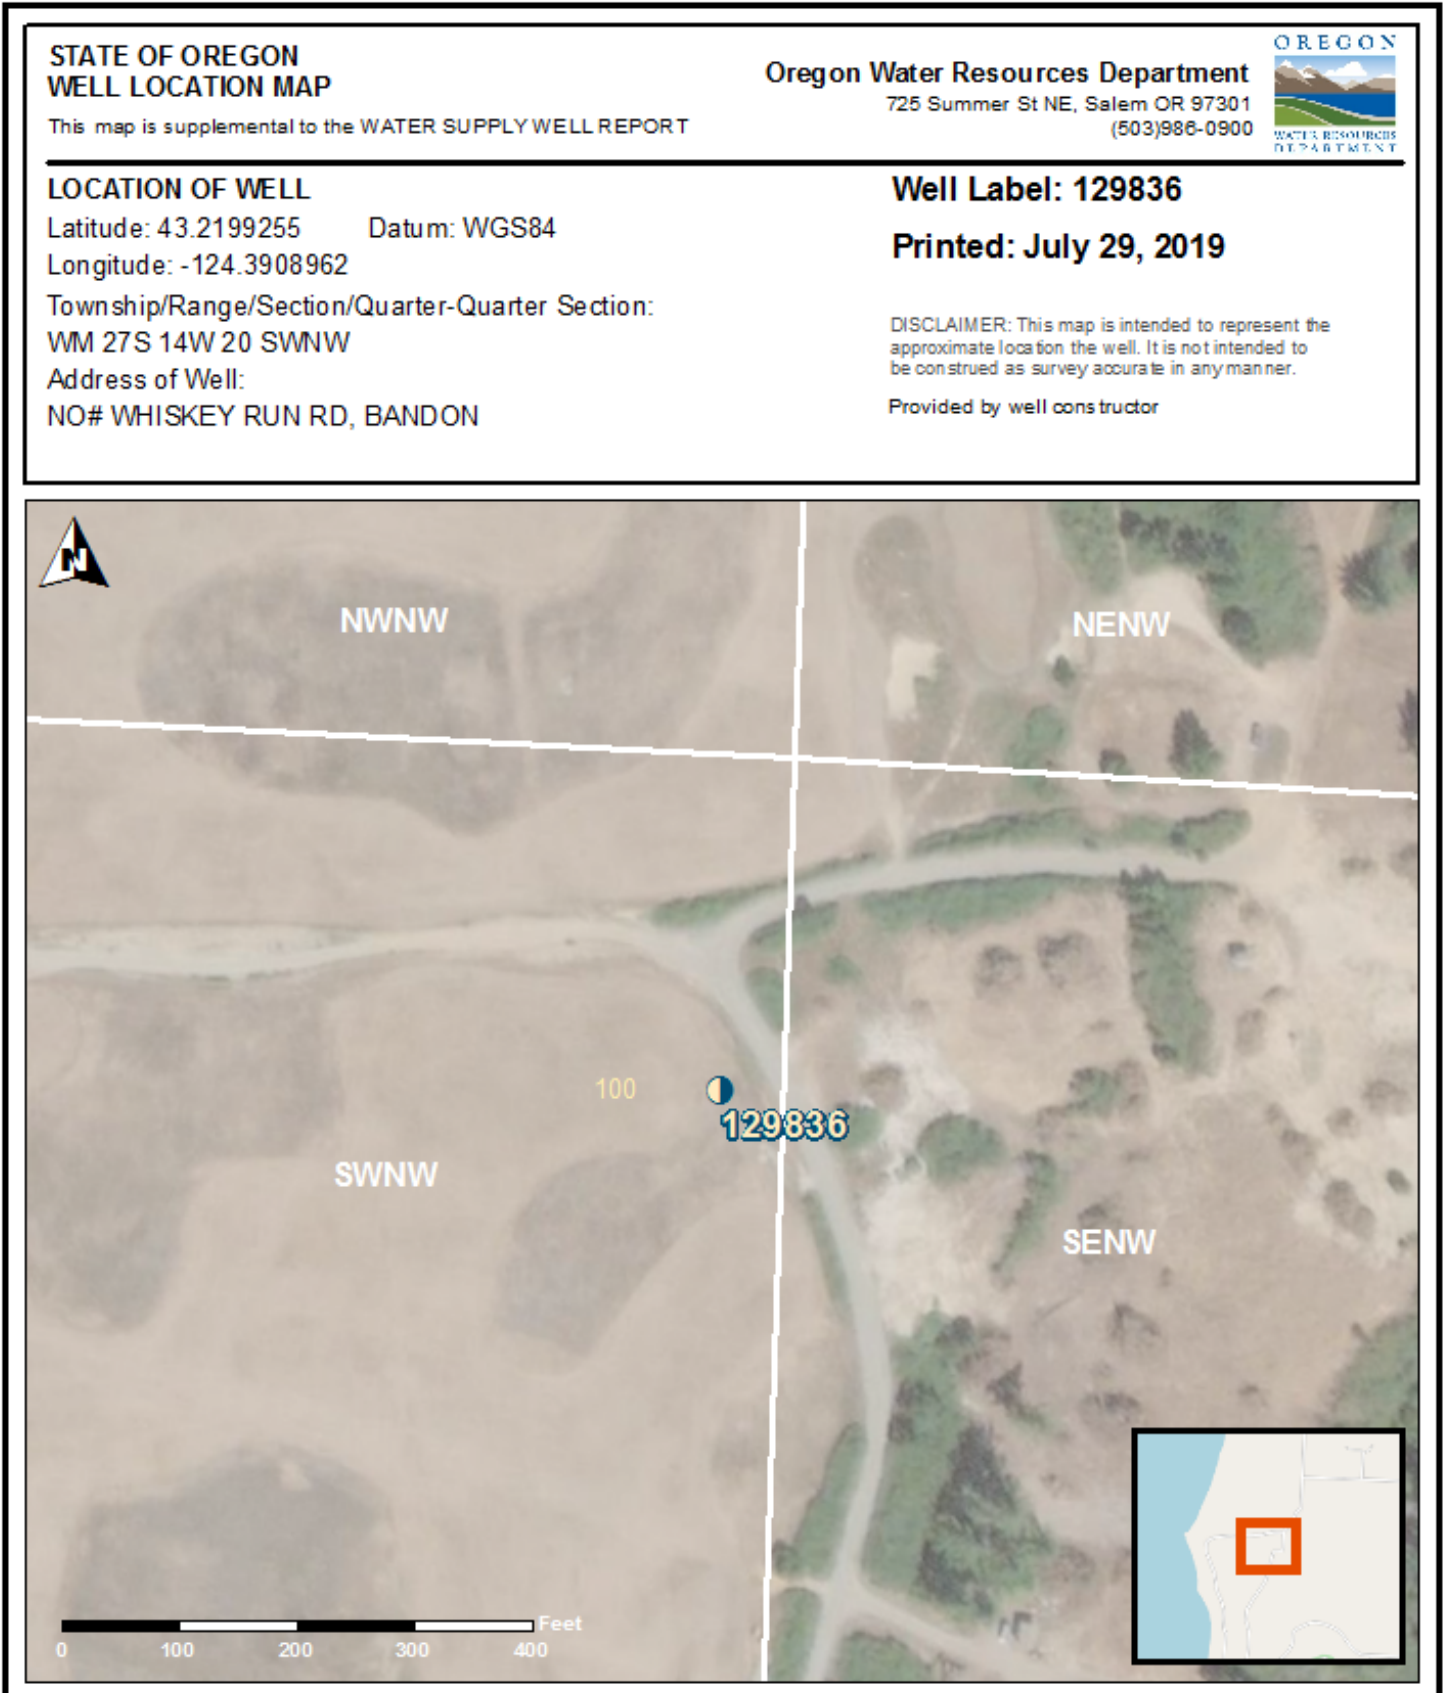

Map of Hole

