

STATE ENGINEER  
Salem, Oregon

CROO  
1030

# Well Record

STATE WELL NO. 14/15-25P(1)  
COUNTY Crook  
APPLICATION NO. U-387

OWNER: Clarence Allen MAILING ADDRESS:

LOCATION OF WELL: Owner's No. CITY AND STATE: Prineville, Oregon


SE 1/4 SW 1/4 Sec. 25 T. 14 N. S. R. 15 W. W.M.

Bearing and distance from section or subdivision corner

Altitude at well

TYPE OF WELL: Drilled Date Constructed

Depth drilled 220 Depth cased

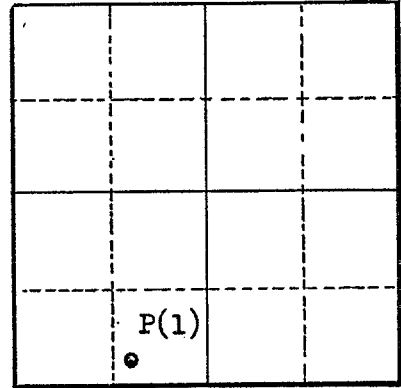

CASING RECORD:

FINISH:

AQUIFERS:  
Sand and gravel at 220 feet

WATER LEVEL:  
Flowing, 30 to 40 lbs. pressure

PUMPING EQUIPMENT: Type None, artesian pressure supplies 20 sprinklers  
Capacity G.P.M.

WELL TESTS:  
Drawdown ft. after hours G.P.M.  
Drawdown ft. after hours G.P.M.

USE OF WATER Irrigation 1.83 acres Temp. °F., 19  
SOURCE OF INFORMATION U-387

DRILLER or DIGGER  
ADDITIONAL DATA:  
Log  Water Level Measurements  Chemical Analysis  Aquifer Test

REMARKS:

