

STATE ENGINEER
Salem, Oregon



Well Record

STATE WELL NO. 14/15-31G(1)
COUNTY Crook
APPLICATION NO. U-232

OWNER: Hudspeth Sawmill Co.

MAILING ADDRESS:


LOCATION OF WELL: Owner's No. 2

CITY AND STATE:

Prineville, Oregon

SW 1/4 NE 1/4 Sec. 31 T. 14 N. S., R. 15 E. W., W.M.

Bearing and distance from section or subdivision corner

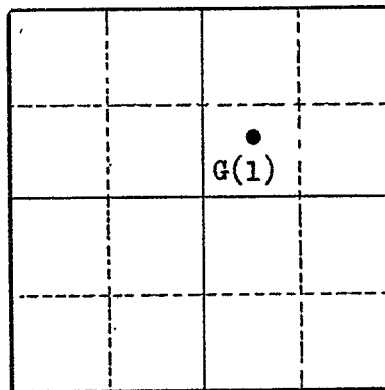

Section

Altitude at well

TYPE OF WELL: Drilled Date Constructed

Depth drilled 400 Depth cased

CASING RECORD:

FINISH:

AQUIFERS:

WATER LEVEL:

PUMPING EQUIPMENT: Type _____ H.P. _____
Capacity _____ G.P.M.

WELL TESTS:
Drawdown _____ ft. after _____ hours _____ G.P.M.
Drawdown _____ ft. after _____ hours _____ G.P.M.

USE OF WATER Log pond Temp. _____ °F. _____, 19____

SOURCE OF INFORMATION _____

DRILLER or DIGGER _____

ADDITIONAL DATA:
Log x Water Level Measurements _____ Chemical Analysis _____ Aquifer Test _____

REMARKS:

