

STATE ENGINEER
Salem, Oregon

CROO
1146

Well Record


STATE WELL NO. 14/15-36H(1)
COUNTY Crook
APPLICATION NO. U-160

OWNER: L. R. Lynam Alton Basey MAILING ADDRESS: _____

LOCATION OF WELL: Owner's No. _____ CITY AND STATE: Terrebonne, Oregon

SE 1/4 NE 1/4 Sec. 36 T. 14 N. S., R. 15 E. W., W.M.

Bearing and distance from section or subdivision corner 2595' South and 1392' East of N 1/4 cor.

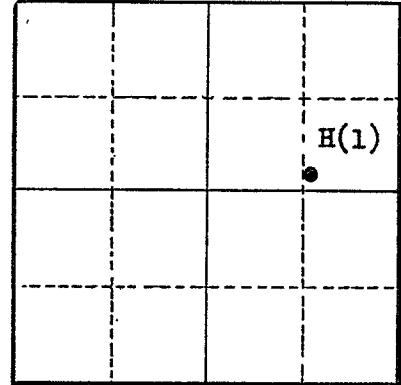

Section 36

Altitude at well 2844'

TYPE OF WELL: Drilled Date Constructed 1944

Depth drilled 220 Depth cased 214

CASING RECORD:

6-inch, set to 214 feet

FINISH:

AQUIFERS:

Sand and gravel from 214 to 220 feet

WATER LEVEL:

+32 (10-26-44) +17.5 (11-18-53)

PUMPING EQUIPMENT: Type _____ H.P. _____
Capacity _____ G.P.M.

WELL TESTS:

Drawdown _____ ft. after _____ hours _____ G.P.M.

Drawdown _____ ft. after _____ hours _____ G.P.M.

USE OF WATER Domestic irrigation Temp. _____ °F., 19 _____

SOURCE OF INFORMATION U-160 U.S.G.S. Report

DRILLER or DIGGER George E. Scott

ADDITIONAL DATA:

Log Water Level Measurements _____ Chemical Analysis _____ Aquifer Test _____

REMARKS:

Alton Basey well in report of U.S.G.S. on Prineville Area
Flowed 120 gpm for 8 hr. drawdown 13.5 feet

STATE ENGINEER
Salem, Oregon

State Well No. 14/15-36G(1)


Application No. _____

Water Level Record

OWNER: C.W. Woodford (now H. G. Eldridge) OWNER'S NO. _____

Description of measuring point: Top of plug in casing 9.5 ft above LSD

LSD = 2851

Date	Water Level Feet (above) (below) Land Surface	Remarks	Date	Water Level Feet (above) (below) Land Surface	Remarks
10-26-44	17.0	USGS WSP 1027			
1-16-45	15.5	" "			
5-6-45	8.0	" "			
7-25-45	2.5	" "			
9-25-45	5.7	" "			
12-7-45	5.5	" "			
5-1-46	8.0	USGS WSP 1075			
7-8-46	9.5	" "			
9-5-46	9.5	" "			
11-14-46	10.0	" "			
3-18-47	12.0	USGS WSP 1100			
5-12-47	7.5	" "			
— DISCONTINUED —					

REMARKS: _____

