CROO 1374

STATE ENGINEER
Salem, Oregon

CROO 1374

Well Record

STATE WELL NO. 14/16-29N(1)
COUNTY Crook
APPLICATION NO. G-148

OWNER: Alexander-Stewart Lumber Co.

MAILING ADDRESS:


CITY AND STATE: Prineville, Oregon 97754

LOCATION OF WELL: Owner's No.

SW ¼ SW ¼ Sec. 29 T. 14 N. S., R. 16 E. W., W.M.

Bearing and distance from section or subdivision corner N 74° E 456' of SW cor. Sec. 29

Altitude at well

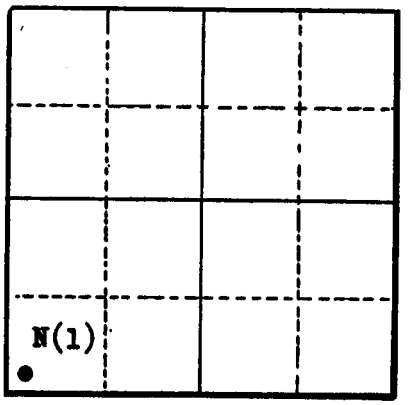

Section 29

TYPE OF WELL: Drilled Date Constructed

Depth drilled Depth cased

CASING RECORD:

12-inch

FINISH:

AQUIFERS:

WATER LEVEL:

PUMPING EQUIPMENT: Type H.P.
Capacity G.P.M.

WELL TESTS:
Drawdown ft. after hours G.P.M.
Drawdown ft. after hours G.P.M.

USE OF WATER Temp. °F., 19
SOURCE OF INFORMATION
DRILLER or DIGGER
ADDITIONAL DATA:
Log Water Level Measurements Chemical Analysis Aquifer Test

REMARKS:

State Printing 89316