

STATE ENGINEER
Salem, Oregon

CROO
1549

CROO 1549
Well Record

WELL NO. 14/16-31J(1)
COUNTY **Crook**
APPLICATION NO. **U-140**

OWNER: **City of Prineville** MAILING ADDRESS: _____

LOCATION OF WELL: Owner's No. _____ CITY AND STATE: _____


NE 1/4 **SE** 1/4 Sec. **31** T. **14** **N.** S., R. **16** **E.** W., W.M.

Bearing and distance from section or subdivision corner _____

Altitude at well **2868**

TYPE OF WELL: **Drilled** Date Constructed **May 1941**

Depth drilled **223** Depth cased _____

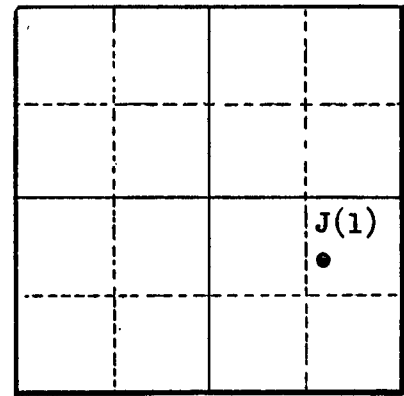

Section **31**

CASING RECORD:

6-inch, set to 222 feet

FINISH:

AQUIFERS:

Sand and gravel from 222 to 223 feet

WATER LEVEL:

4.8 feet above land surface, October 26, 1944

PUMPING EQUIPMENT: Type **Centrifugal** H.P. **1**
Capacity _____ G.P.M.

WELL TESTS:

Drawdown _____ ft. after _____ hours _____ G.P.M.
Drawdown _____ ft. after _____ hours _____ G.P.M.

USE OF WATER **Municipal** Temp. _____ °F. _____, 19____

SOURCE OF INFORMATION **U.S.G.S. Report U-140**

DRILLER or DIGGER _____

ADDITIONAL DATA:

Log Water Level Measurements Chemical Analysis _____ Aquifer Test _____

REMARKS:

