

STATE ENGINEER  
Salem, Oregon



CROO 1552  
**Well Record**


STATE WELL NO. 14/16-31G(1)  
COUNTY Crook  
APPLICATION NO.

OWNER: Hudspeth Pine Co., Inc. MAILING ADDRESS:

LOCATION OF WELL: Owner's No. CITY AND STATE:

..... 1/4 ..... 1/4 Sec. .... T. .... N. .... E. .... S., R. .... W., W.M.

Bearing and distance from section or subdivision corner

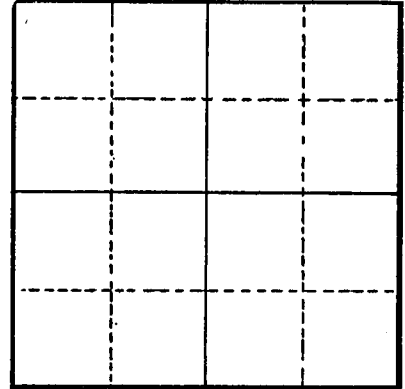

Section .....

Altitude at well ..... 2,940+ .....

TYPE OF WELL: Drilled Date Constructed 1948

Depth drilled ..... 288 ..... Depth cased ..... 286.5 .....

**CASING RECORD:**

10 inch

**FINISH:**

**AQUIFERS:**

Sand and gravel from 281 to 288

**WATER LEVEL:**

45 feet below land surface on January 30, 1948

55.86 feet below land surface on April 15, 1954

PUMPING EQUIPMENT: Type Turbine H.P. Capacity 185 G.P.M.

**WELL TESTS:**

Drawdown ..... ft. after ..... hours ..... G.P.M.

Drawdown ..... ft. after ..... hours ..... G.P.M.

USE OF WATER Industrial Temp. .... °F. ...., 19.....

SOURCE OF INFORMATION .....

DRILLER or DIGGER .....

**ADDITIONAL DATA:**

Log  Water Level Measurements ..... Chemical Analysis ..... Aquifer Test .....

**REMARKS:**

