

STATE ENGINEER
Salem, Oregon

Well Record
CROOK
2032


STATE WELL NO. 15/16-1E(1)
COUNTY Crook
APPLICATION NO. U-164

OWNER: Robert Hogan and Ann Dornecker MAILING ADDRESS: _____

LOCATION OF WELL: Owner's No. _____ CITY AND STATE: Prineville, Oregon

SW $\frac{1}{4}$ NW $\frac{1}{4}$ Sec. 1 T. 15 N. S., R. 16 E. W., W.M.

Bearing and distance from section or subdivision corner Well is 1340 South and 1300' East of NW corner

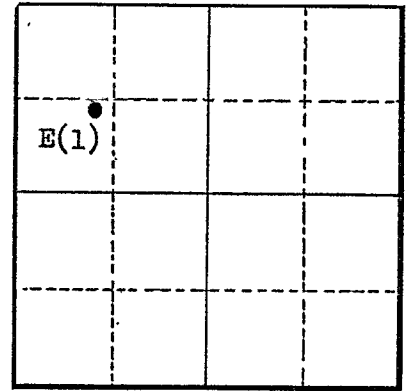

Section 1

Altitude at well _____

TYPE OF WELL: Drilled Date Constructed _____

Depth drilled 60 Depth cased _____

CASING RECORD:

10-inch

FINISH:

AQUIFERS:

WATER LEVEL:

PUMPING EQUIPMENT: Type _____ H.P. _____
Capacity 360 G.P.M.

WELL TESTS:

Drawdown _____ ft. after _____ hours _____ G.P.M.
Drawdown _____ ft. after _____ hours _____ G.P.M.

USE OF WATER Irrigation - Golf course Temp. _____ °F. _____, 19____
SOURCE OF INFORMATION U-164

DRILLER or DIGGER _____

ADDITIONAL DATA:

Log _____ Water Level Measurements _____ Chemical Analysis _____ Aquifer Test _____

REMARKS: