466da

STATE ENGINEER
Salem, Oregon

CROOK 2D80

Well Record

STATE WELL NO. 15/16-[illegible]
COUNTY Crook
APPLICATION NO. .....

OWNER: Hickey's


MAILING ADDRESS: Rt. 1, Box 257

LOCATION OF WELL: Owner's No. .....

CITY AND STATE: Prineville, Oregon

NW ¼ NW ¼ Sec. 4 T. 15 S., R. 16 E., W.M.

Bearing and distance from section or subdivision corner 690' S. & 1263' E. of NW cor. sec. 4.

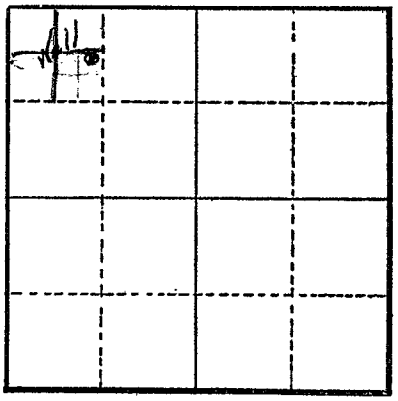

Altitude at well .....

TYPE OF WELL: Dug Date Constructed 1946

Depth drilled 22 ft. Depth cased 16 ft.

Section 4

CASING RECORD:

36 inch galvanized from surface to 16 ft.

FINISH:

AQUIFERS:

WATER LEVEL:

7 ft.

PUMPING EQUIPMENT: Type Meyers Jet H.P. 1 & 3

Capacity 20 & 100 G.P.M.

WELL TESTS:

Drawdown 4 ft. after ..... hours 40 G.P.M.

Drawdown 7 ft. after ..... hours 80 G.P.M.

USE OF WATER Dom. & irrigation Temp. ..... °F. ....., 19....

SOURCE OF INFORMATION Belated registration statement

DRILLER or DIGGER .....

ADDITIONAL DATA:

Log ..... Water Level Measurements ..... Chemical Analysis ..... Aquifer Test .....

REMARKS:

Log:

Soil	0 to	4½ ft.
Pumice sand	4½ to	9½ ft.
Gravel (pea) H20	9½ to	15½ ft.
Gravel & clay	15½ to	17½ ft.
Gravel & sand & rock (water)	17½ to	22 ft.

State Printing 89316