STATE ENGINEER
Salem, Oregon

CR00 2086

Well Record


STATE WELL NO. 15/16-4E
COUNTY Crook
APPLICATION NO. .....

OWNER: Floyd S. Williamson
MAILING ADDRESS: 105 Willowdale Road
CITY AND STATE: Prineville, Oregon

LOCATION OF WELL: Owner's No. .....

SW ¼ NW ¼ Sec. 4 T. 15 S., R. 16 E., W.M.

Bearing and distance from section or subdivision corner .....

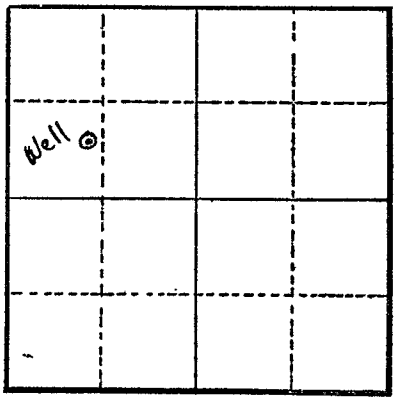

Altitude at well 2280 ft.

TYPE OF WELL: Driven Date Constructed 1956

Depth drilled 20 ft. Depth cased .....

Section 4

CASING RECORD:
3 inch

FINISH:

AQUIFERS:

WATER LEVEL:
8 ft.

PUMPING EQUIPMENT: Type 1½" Rainflow H.P. 1
Capacity 40 G.P.M.

WELL TESTS:
Drawdown ..... ft. after ..... hours ..... G.P.M.
Drawdown ..... ft. after ..... hours ..... G.P.M.

USE OF WATER Irrigation Temp. ..... °F. ....., 19.....
SOURCE OF INFORMATION Belated registration statement
DRILLER or DIGGER .....
ADDITIONAL DATA:
Log ..... Water Level Measurements ..... Chemical Analysis ..... Aquifer Test .....

REMARKS:
Irrigation of 1½ acres.

State Printing 89316