STATE ENGINEER
Salem, Oregon

CR00 2113

Well Record

STATE WELL NO. 15/16-5A(1)
COUNTY Crook
APPLICATION NO. .....


OWNER: O. M. Young

MAILING ADDRESS: .....

CITY AND STATE: .....

LOCATION OF WELL: Owner's No. .....

NE ¼ NE ¼ Sec. 5 T. 15 N. S., R. 16 E. W., W.M.

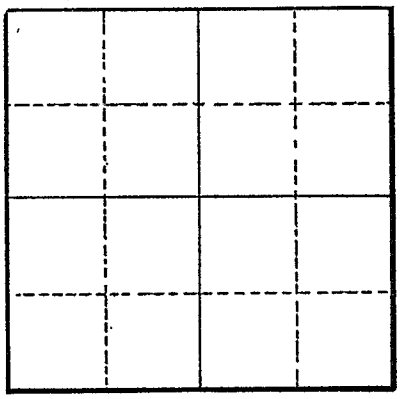

Bearing and distance from section or subdivision corner .....

Altitude at well 2885'

TYPE OF WELL: Driven Date Constructed 1937

Depth drilled 32' Depth cased 32'

Section .....

CASING RECORD:

2-inch

FINISH:

AQUIFERS:

Gravel - unconfined

WATER LEVEL:

4'

PUMPING EQUIPMENT: Type Piston H.P. .....
Capacity 10 G.P.M.

WELL TESTS:
Drawdown ..... ft. after ..... hours ..... G.P.M.
Drawdown ..... ft. after ..... hours ..... G.P.M.

USE OF WATER Public supply Temp. ..... °F. ....., 19.....
SOURCE OF INFORMATION U.S.G.S.
DRILLER or DIGGER .....
ADDITIONAL DATA:
Log ..... Water Level Measurements ..... Chemical Analysis ..... Aquifer Test .....

REMARKS:

Typical of shallow gravel zone along lower plain

State Printing 89316