STATE ENGINEER
Salem, Oregon

Well Record

CROO 2114


STATE WELL NO. 15/16-5A(2)
COUNTY Crook
APPLICATION NO. .....

OWNER: O. M. Young
MAILING ADDRESS: .....
CITY AND STATE: .....

LOCATION OF WELL: Owner's No. .....

NE ¼ NE ¼ Sec. 5 T. 15 N. S., R. 16 E. W., W.M.

Bearing and distance from section or subdivision corner .....

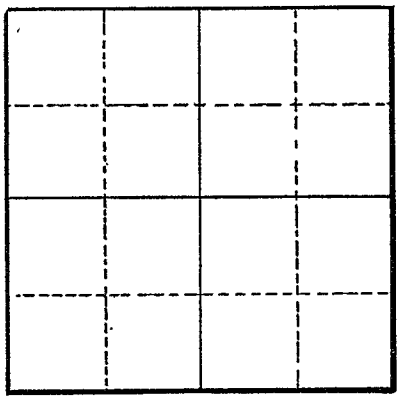

Section .....

Altitude at well 2885'

TYPE OF WELL: Drilled Date Constructed 1941

Depth drilled 96' Depth cased 63'

CASING RECORD:

6-inch

FINISH:

AQUIFERS:

Fine sand - unconfined (?)

WATER LEVEL:

62.4'

PUMPING EQUIPMENT: Type None H.P. .....
Capacity ..... G.P.M.

WELL TESTS:
Drawdown ..... ft. after ..... hours ..... G.P.M.
Drawdown ..... ft. after ..... hours ..... G.P.M.

USE OF WATER ..... Temp. ..... °F. ....., 19.....
SOURCE OF INFORMATION U.S.G.S.
DRILLER or DIGGER .....
ADDITIONAL DATA:
Log ..... Water Level Measurements ..... Chemical Analysis ..... Aquifer Test .....

REMARKS:
Well reported sanded up to 64' water reported softer than shallow water

State Printing 89316

STATE ENGINEER
Salem, Oregon

State Well No. 15/16-5A(2)

County Crook

Application No. .....

Water Level Record

OWNER: O.M. Young OWNER'S NO. .....

Description of measuring point: Top of Casing

LSD 2885

Date	Water Level Feet (above) (below) Land Surface	Remarks	Date	Water Level Feet (above) (below) Land Surface	Remarks
10 23 44	6.20	USGS WSP 1027			
6-20-45	5.59	"			
7-27-45	5.55	"			
9-25-45	5.29	"			
12-6-45	6.05	"			
5-1-46	5.06	WSP 1075			
7-9-46	5.75	"			
9-5-46	4.67	"			
3-18-47	7.04	WSP 1100			
5-12-47	6.27	"			
— DISCONTINUED —					

REMARKS: .....

State Printing 89314