

STATE ENGINEER
Salem, Oregon

CROOK
2115

Well Record

STATE WELL NO. 15/16-5B(1)
COUNTY Crook
APPLICATION NO. U-170

OWNER: G. W. Burnet

MAILING ADDRESS:
CITY AND STATE:

LOCATION OF WELL: Owner's No. _____


NW $\frac{1}{4}$ NE $\frac{1}{4}$ Sec. 5 T. 15 N. S., R. 16 W., W.M.

Bearing and distance from section or subdivision corner _____

Altitude at well _____

TYPE OF WELL: Drilled Date Constructed June 1945

Depth drilled 54' Depth cased 54'

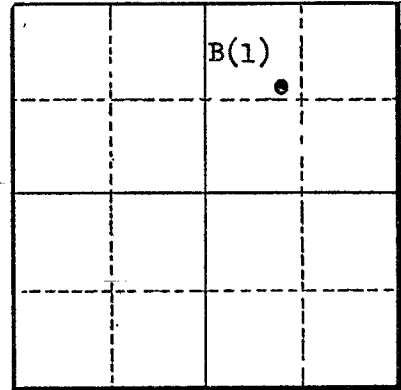

Section 5

CASING RECORD:

FINISH:

AQUIFERS:

sand

WATER LEVEL:

3.5 feet below land surface, June, 1945

PUMPING EQUIPMENT: Type _____ H.P. _____
Capacity _____ G.P.M.

WELL TESTS:

Drawdown _____ ft. after _____ hours _____ G.P.M.

Drawdown _____ ft. after _____ hours _____ G.P.M.

USE OF WATER Irrigation Temp. _____ °F. _____, 19____

SOURCE OF INFORMATION U-170

DRILLER or DIGGER _____

ADDITIONAL DATA:

Log Water Level Measurements _____ Chemical Analysis _____ Aquifer Test _____

REMARKS:

Log
Black loam 0 to 6 feet
clay, gravel hard 6 to 30 feet
sand, coarse 30 to 54 feet