STATE ENGINEER
Salem, Oregon

CROO
2122


Well Record

STATE WELL NO. 15/16-5D(1)7
COUNTY Crook
APPLICATION NO. .....

OWNER: Crook County
MAILING ADDRESS: .....
CITY AND STATE: .....

LOCATION OF WELL: Owner's No. .....

NW ¼ NW ¼ Sec. 5 T. 15 ~~N.~~ S., R. 16 ~~E.~~ W., W.M.

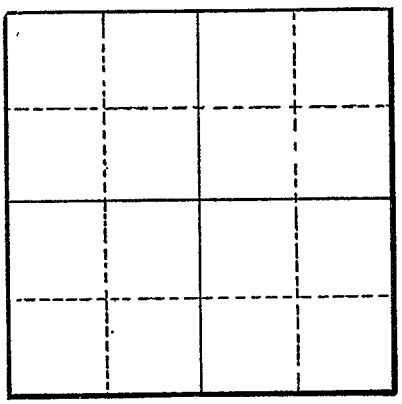

Bearing and distance from section or subdivision corner .....

Altitude at well 2869'

TYPE OF WELL: Drilled Date Constructed 1915

Depth drilled 70' Depth cased 64'

Section .....

CASING RECORD:

5 - 5/8-inch

FINISH:

AQUIFERS:

sandy silt - unconfined

WATER LEVEL:

4-5 feet

PUMPING EQUIPMENT: Type ..... H.P. .....
Capacity ..... G.P.M.

WELL TESTS:
Drawdown ..... ft. after ..... hours ..... G.P.M.
Drawdown ..... ft. after ..... hours ..... G.P.M.

USE OF WATER Public supply Temp. ..... °F. ....., 19.....
SOURCE OF INFORMATION U.S.G.S.
DRILLER or DIGGER .....
ADDITIONAL DATA:
Log ..... Water Level Measurements ..... Chemical Analysis ..... Aquifer Test .....

REMARKS:

State Printing 89316