STATE ENGINEER
Salem, Oregon

CROO 2128

Well Record


STATE WELL NO. 15/16-5D(1)8
COUNTY Crook
APPLICATION NO. .....

OWNER: Pacific Power & Light Co.
MAILING ADDRESS: .....
CITY AND STATE: .....

LOCATION OF WELL: Owner's No. .....

..... ¼ ..... ¼ Sec. ..... T. ..... N. S., R. ..... E. W., W.M.

Bearing and distance from section or subdivision corner .....

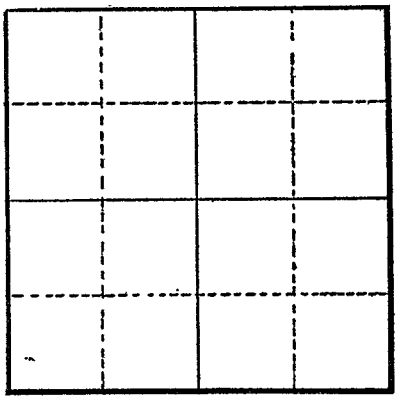

Section .....

Altitude at well 2,865

TYPE OF WELL: Drilled Date Constructed 1950

Depth drilled 160 Depth cased .....

CASING RECORD:

12 inch

FINISH:

AQUIFERS:

Fine gravel and sand from 147 to 148

WATER LEVEL:
10 feet

PUMPING EQUIPMENT: Type ..... H.P. .....
Capacity ..... G.P.M.

WELL TESTS:
Drawdown ..... ft. after ..... hours ..... G.P.M.
Drawdown ..... ft. after ..... hours ..... G.P.M.

USE OF WATER None Temp. ..... °F. ....., 19.....
SOURCE OF INFORMATION USGS
DRILLER or DIGGER .....
ADDITIONAL DATA:
Log X Water Level Measurements ..... Chemical Analysis ..... Aquifer Test .....

REMARKS:

Well abandoned, casing pulled.

State Printing 89316

STATE ENGINEER
Salem, Oregon

State Well No. 15/16-5D(1)8
County Crook
Application No.

Well Log

Owner: Pacific Power & Light Co. Owner's No.

Driller: Date Drilled 1950

CHARACTER OF MATERIAL	(Feet below land surface) From	To	Thickness (feet)
Alluvium:			
Soil	0	3	3
Gravel, light	3	4	1
Silt and gravel	4	10	6
Gravel, sandy, water-bearing	10	14	4
Fluviolacustrine deposits:			
Clay	14	16	2
Silt, sandy	16	26	10
Clay, blue	26	30	4
Sand, dark	30	55	25
Clay, dark	55	90	35
Sand, gray, fine	90	110	20
Clay	110	147	37
Gravel, fine (3/8 inch) and sand, water-bearing	147	148	1
Clay	148	160	12
Casing: pulled, well abandoned.			