STATE ENGINEER
Salem, Oregon

Well Record

Dupl. copy sec 5 bc

CROO 2124

STATE WELL NO. 15/~~16~~-5D(1)9
COUNTY Crook
APPLICATION NO.

OWNER: Pacific Power & Light Co.

MAILING ADDRESS:

CITY AND STATE:

LOCATION OF WELL: Owner's No.

¼ ¼ Sec. T. N. S., R. E. W., W.M.

Bearing and distance from section or subdivision corner

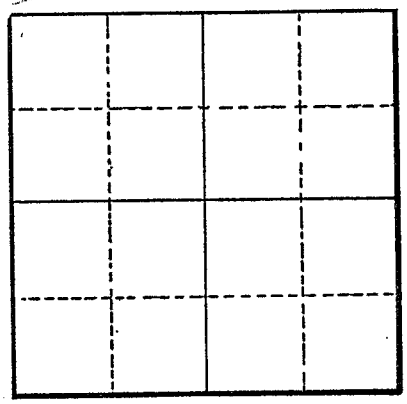

Altitude at well 2,865

Section

TYPE OF WELL: Drilled Date Constructed 1950

Depth drilled 252 ✓ Depth cased

CASING RECORD:

12 inch

FINISH:

AQUIFERS:

Gravel from 220 to 230

WATER LEVEL:
22 feet below land surface, 1950

PUMPING EQUIPMENT: Type Turbine H.P.
Capacity 620 G.P.M.

WELL TESTS:
Drawdown ft. after hours G.P.M.
Drawdown ft. after hours G.P.M.

USE OF WATER Public Supply Temp. °F. , 19
SOURCE OF INFORMATION USGS
DRILLER or DIGGER
ADDITIONAL DATA:
Log Water Level Measurements Chemical Analysis X Aquifer Test

REMARKS:
Water reportedly contains silt.

State Printing 89316

STATE ENGINEER
Salem, Oregon

State Well No. 15/1[illegible]-5D(1)9

County ~~XX~~ Crook

Application No.

Chemical Analysis

OWNER Pacific Power and Light OWNER'S NO.

ANALYST Charlton Laboritories Address Portland

Date of Collection Oct. 1959

Point of Collection

	P.P.M.	E.P.M.
Silica (SiO_2)		
Iron (Fe) Total	0.16	
Manganese (Mn)		
Calcium (Ca)		
Magnesium (Mg)		
Sodium (Na)		
Potassium (K)		
Bicarbonate (HCO_3)	137.	
Carbonate (CO_3)		
Sulfate (SO_4)	25.	
Chloride (Cl)	11.	
Fluoride (F)		
Nitrate (NO_3)		
Boron (B)		
Dissolved Solids	260.	
Hardness as $CaCO_3$	140.	
Specific Conductance (Micromhos at 25°C)		
pH	7.3	
Percent Sodium		
Sodium Absorption Ratio (S.A.R.)		
CLASS		

State Printing 89313