STATE ENGINEER
Salem, Oregon

CROO 2189

Well Record

STATE WELL NO. 15/16-5E(2)
COUNTY Crook
APPLICATION NO. U-402

OWNER: Pacific Power & Light Co.


MAILING ADDRESS:

CITY AND STATE: Prineville, Oregon

LOCATION OF WELL: Owner's No.

SW ¼ NW ¼ Sec. 5 T. 15 N. S., R. 16 E. W., W.M.

Bearing and distance from section or subdivision corner

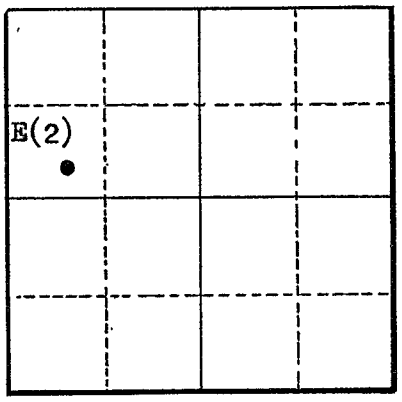

Section 5

Altitude at well

TYPE OF WELL: Drilled Date Constructed

Depth drilled Depth cased

CASING RECORD:

FINISH:

AQUIFERS:

WATER LEVEL:

PUMPING EQUIPMENT: Type H.P.
Capacity G.P.M.

WELL TESTS:
Drawdown ft. after hours G.P.M.
Drawdown ft. after hours G.P.M.

USE OF WATER Temp. °F., 19
SOURCE OF INFORMATION Log in U-402
DRILLER or DIGGER
ADDITIONAL DATA:
Log X Water Level Measurements Chemical Analysis Aquifer Test

REMARKS:

Well abandoned and casing pulled

State Printing 89316

STATE ENGINEER
Salem, Oregon

State Well No. 15/16-5E(2)
County Crook
Application No. .....

Well Log

Owner: Pacific Power & Light Co. Owner's No. .....

Driller: ..... Date Drilled .....

CHARACTER OF MATERIAL	(Feet below land surface) From	To	Thickness (feet)
Soil	0	3	3
Gravel	3	4	1
Silt and gravel	4	10	6
Gravel	10	14	4
Clay	14	16	2
Silt, sandy	16	26	10
Clay, blue	26	30	4
Sand	30	55	25
Clay	55	90	35
Silt	90	100	10
Sand	100	110	10
Clay	110	147	37
Gravel, fine, water bearing	147	148	1
Clay	148	156	8
Well abandoned, casing pulled			