STATE ENGINEER
Salem, Oregon

CROO 2131

Well Record

STATE WELL NO. 15/16-5D(1)6
COUNTY Crook
APPLICATION NO. .....


OWNER: Crook County

MAILING ADDRESS: .....

CITY AND STATE: .....

LOCATION OF WELL: Owner's No. .....

NW ¼ NW ¼ Sec. 5 T. 15 N. S., R. 16 E. W., W.M.

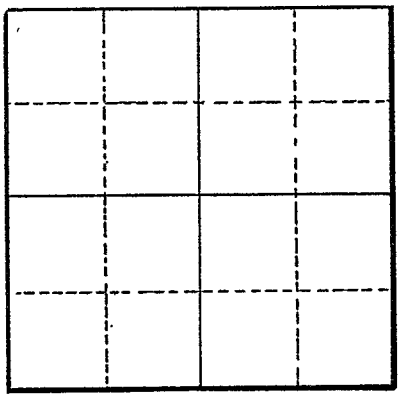

Bearing and distance from section or subdivision corner .....

Altitude at well 2869'

TYPE OF WELL: Drilled Date Constructed 1915

Depth drilled 510' Depth cased .....

Section .....

CASING RECORD:

FINISH:

AQUIFERS:

Sand - unconfined

WATER LEVEL:

4-5'

PUMPING EQUIPMENT: Type ..... H.P. .....
Capacity ..... G.P.M.

WELL TESTS:
Drawdown ..... ft. after ..... hours ..... G.P.M.
Drawdown ..... ft. after ..... hours ..... G.P.M.

USE OF WATER Public supply Temp. ..... °F. ....., 19.....
SOURCE OF INFORMATION U.S.G.S.
DRILLER or DIGGER .....
ADDITIONAL DATA:
Log ..... Water Level Measurements ..... Chemical Analysis ..... Aquifer Test .....

REMARKS:

Alluvium penetrated to 184 feet. Dry bedrock below

State Printing 89316