STATE ENGINEER
Salem, Oregon

CROO
2222

Well Record


STATE WELL NO. 15/16-6A(2)
COUNTY Crook
APPLICATION NO. .....

OWNER: Thomas Smith
MAILING ADDRESS: .....
CITY AND STATE: .....

LOCATION OF WELL: Owner's No. .....

NE ¼ NE ¼ Sec. 6 T. 15 S., R. 16 E. W., W.M.

Bearing and distance from section or subdivision corner .....

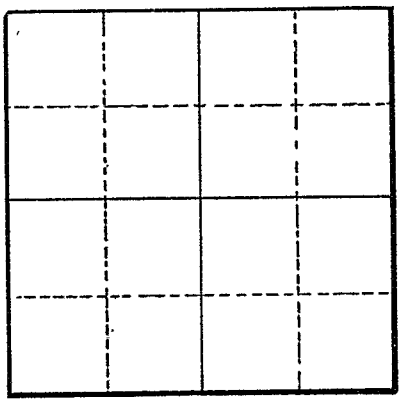

Section .....

Altitude at well 2858'

TYPE OF WELL: Drilled Date Constructed .....

Depth drilled ..... Depth cased .....

CASING RECORD:

6-inch

FINISH:

AQUIFERS:

confined

WATER LEVEL:

12.6' + (10-26-44)

PUMPING EQUIPMENT: Type Piston H.P. .....
Capacity 10 G.P.M.

WELL TESTS:
Drawdown ..... ft. after ..... hours ..... G.P.M.
Drawdown ..... ft. after ..... hours ..... G.P.M.

USE OF WATER Domestic, stock Temp. 58 °F. ....., 19....
SOURCE OF INFORMATION U.S.G.S.
DRILLER or DIGGER .....
ADDITIONAL DATA:
Log ..... Water Level Measurements ..... Chemical Analysis ..... Aquifer Test .....

REMARKS:

State Printing 89316

STATE ENGINEER
Salem, Oregon

State Well No. 15/16 - 6A(2)

County CROOK

Application No. _____

Water Level Record

OWNER: TOM SMITH OWNER'S NO. _____

Description of measuring point: WATER LEVELS IN FEET "ABOVE" L.S.D.

Date	Water Level Feet (above) ~~(below)~~ Land Surface	Remarks	Date	Water Level Feet (above) ~~(below)~~ Land Surface	Remarks
10-26-44	12.6	WSP-1027			
1-16-45	17.0	✓			
6-6-45	14.0	✓			
6-21-45	11.5	✓			
7-25-45	11.8	✓			
9-25-45	17.0	✓			
12-6-45	19.0	✓			
5-1-46	17.0	WSP-1075			
7-9-46	13.0	✓			
9-5-46	13.0	✓			
11-14-46	11.0	✓			
3-18-47	14.5	W.S.P. - 1100			
5-12-47	10.0	✓			

REMARKS: MEASUREMENTS DISCONTINUED AFTER 1947

State Printing 89314