#91

STATE ENGINEER
Salem, Oregon

CROO 50182

OBSERVATION WELL
Well Record


STATE WELL NO. 14/16-32N(1)
COUNTY Crook
APPLICATION NO. .....

OWNER: E. Wagoner (Roy Fulmer) MAILING ADDRESS: .....

LOCATION OF WELL: Owner's No. ..... CITY AND STATE: .....

SW ¼ SW ¼ Sec. 32 T. 14 S., R. 16 E., W.M.

Bearing and distance from section or subdivision corner .....

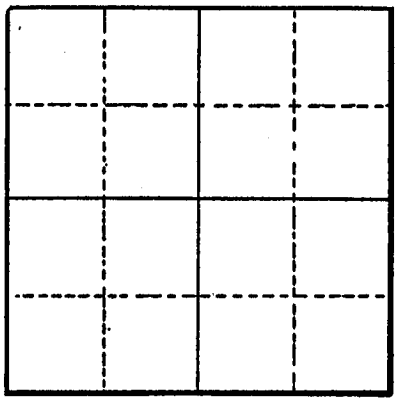

Altitude at well 2866'

TYPE OF WELL: Drilled Date Constructed 1912

Depth drilled 160' Depth cased .....

Section .....

CASING RECORD:

4-5/8 inch

FINISH:

AQUIFERS:

confined

WATER LEVEL:

.90'

PUMPING EQUIPMENT: Type None H.P. .....
Capacity ..... G.P.M.

WELL TESTS:
Drawdown ..... ft. after ..... hours ..... G.P.M.
Drawdown ..... ft. after ..... hours ..... G.P.M.

USE OF WATER None Temp. ..... °F. ....., 19.....
SOURCE OF INFORMATION U.S.G.S.
DRILLER or DIGGER .....
ADDITIONAL DATA:
Log ..... Water Level Measurements ..... Chemical Analysis ..... Aquifer Test .....

REMARKS:

Formerly flowed; water stage recorded at well from June 6, 1945 until November 15, 1946

State Printing 89316