			WELL I.D. LABEL	# T		Page 1 of 3
STATE OF OREGON CROO WATER SUPPLY WELL REPORT		54523	START CARD			
(as required by ORS 537.765 & OAR 690-205-0210) 8/10/		017	ORIGINAL LOG	10515	49	
			OKIOII(AL LOG	π		
(1) LAND OWNER     Owner Well I.D. RUSSELL       First Name     Last Name	· ·		NOFWELL (logg	docerir	tion)	
Company WAIBEL PROPERTIES LLC		(9) LOCATION OF WELL (legal description) County <u>CROOK</u> Twp 15.00 <u>S</u> N/S Range 16.00 <u>E</u> E/W WM				
Address 8055 SW POWELL BUTTE HWY			$E = \frac{1/4 \text{ of the } SE}{1/4 \text{ of the } SE}$			
City     POWELL BUTTE     State     OR     Zip     97753       (2)     TYPE OF WORK     X     New Well     Deepening     Conversion						
(2) <b>TYPE OF WORK</b> Alteration (complete 2a & 10) Abandonment(complete 5a)		Lat	" or _44.25162	.000		DMS or DD
(2a) <b>PRE-ALTERATION</b>		Long°	" or	70000		DMS or DD
Dia + From To Gauge Stl Plstc Wld Thrd		() Stree	et address of well	Nearest ad	dress	
		6100 SE PAULIN	NA HWY.			
Material From To Amt sacks/lbs Seal:						
(3) DRILL METHOD	(	(10) STATIC WATER LEVEL				
Rotary Air       Rotary Mud       Cable       Auger       Cable Mud         Reverse Rotary       Other		Date         SWL(psi)         +         SWL(ft)           Existing Well / Pre-Alteration				
		Completed Well 8/4/2017 85				
(4) PROPOSED USE Domestic X Irrigation Community	y	1	Flowing Artesian?		Hole?	
Industrial/ Commericial Livestock Dewatering	W	VATER BEARIN	G ZONES Depth	water was	first found	156.00
Thermal Injection Other		SWL Date	From To	Est Flow	SWL(psi)	+ SWL(ft)
(5) BORE HOLE CONSTRUCTION Special Standard (	(Attach copy)	8/4/2017	156 350	800		85
Depth of Completed Well 350.00 ft.	(	0/4/2017	150 550	000		
BORE HOLE SEAL	sacks/					
Dia         From         To         Material         From         To         A           18         0         38.5         Bentonite Chips         0         38.5	Amt lbs 35 S					
12 38.5 350 Elemente Chips 0 36.5 Calculated 3						
	$\overline{}$	11) WELL LO	C			
		,	Glound Eleva	ation		
How was seal placed: Method A B X C D Other		Top Soil	Aaterial		From 0	To
Backfill placed from ft. to ft. Material		Hard Tan Clay Stone W/ Rock			2	5
Filter pack from ft. to ft. Material Size		Hard Brown Sand Stone			5	31
Explosives used: Yes Type Amount		Soft Grey Basalt Hard Tan Clay Stone			31	65
(5a) ABANDONMENT USING UNHYDRATED BENTONITE		Hard Grey Basalt			65 75	75 156
Proposed Amount Actual Amount			W/ Quartz, Tan Clay Sear	n	156	350
(6) CASING/LINER	[					
Casing Liner Dia + From To Gauge Stl Plstc						
$ \bigcirc \bigcirc 14 \qquad \boxed{1.5  38.5  250} \bigcirc \bigcirc \bigcirc \bigcirc $						
$\bigcirc \bigcirc \bigcirc 10 \qquad \square 10 \qquad 350 \qquad 250 \qquad \bigcirc $						
Shoe Inside Outside Other Location of shoe(s)						
Temp casing Yes Dia From + To To						
(7) PERFORATIONS/SCREENS	-					
Perforations Method Factory Sereons Ture Meterial	—  ,	Data Stanta d(1	0/2017		9/4/2017	
Screens Type Material Perf/ Casing/ Screen Scrn/slot Slot # of		Date Started         6/19/2017         Completed         8/4/2017				
Screen Liner Dia From To width length slots		(unbonded) Water Well Constructor Certification				
Perf Liner 10 270 350 .13 3 3040		I certify that the work I performed on the construction, deepening, alteration, or abandonment of this well is in compliance with Oregon water supply well construction standards. Materials used and information reported above are true to				
		the best of my kn	owledge and belief.		-	
		License Number		Date		
(8) WELL TESTS: Minimum testing time is 1 hour		Signed				
$\bigcirc Pump \qquad \bigcirc Bailer \qquad \textcircled{O} Air \qquad \bigcirc Flowing A$	Artesian	·				
Yield gal/min Drawdown Drill stem/Pump depth Duration (hr)		(bonded) Water Well Constructor Certification				
800 350 8	I accept responsibility for the construction, deepening, alteration, or abandonment work performed on this well during the construction dates reported above. All work					
	1	performed during	this time is in compli	ance with	Oregon wa	ter supply well
Temperature 66 °F Lab analysis Yes By		construction standards. This report is true to the best of my knowledge and belief.				
Water quality concerns? Yes (describe below) TDS amount 111 ppm		License Number 1583 Date 8/10/2017				
From To Description Amount		Signed DAVIE	A SCHLICHTING (E-fi			
			onal)			
		- share into (opti	······/			

ORIGINAL - WATER RESOURCES DEPARTMENT THIS REPORT MUST BE SUBMITTED TO THE WATER RESOURCES DEPARTMENT WITHIN 30 DAYS OF COMPLETION OF WORK Form Version:

WATER SUPPLY WELL REPORT - Map with location identified must be attached and shall include an approximate scale and north arrow **CROO 54523** 

8/10/2017

Map of Hole

### STATE OF OREGON WELL LOCATION MAP

This map is supplemental to the WATER SUPPLY WELL REPORT

## LOCATION OF WELL

Latitude: 44.2516192864 Datum: WGS84 Longitude: -120.74789311905 Township/Range/Section/Quarter-Quarter Section: WM 15S 16E 24 NESE Address of Well: 6100 SE PAULINA HWY.

#### Oregon Water Resources Department 725 Summer St NE, Salem OR 97301


725 Summer St NE, Salem OR 97301 (503)986-0900



# Well Label: 111997 Printed: August 10, 2017

DISCLAIMER: This map is intended to represent the approximate location the well. It is not intended to be construed as survey accurate in any manner.

Provided by well constructor

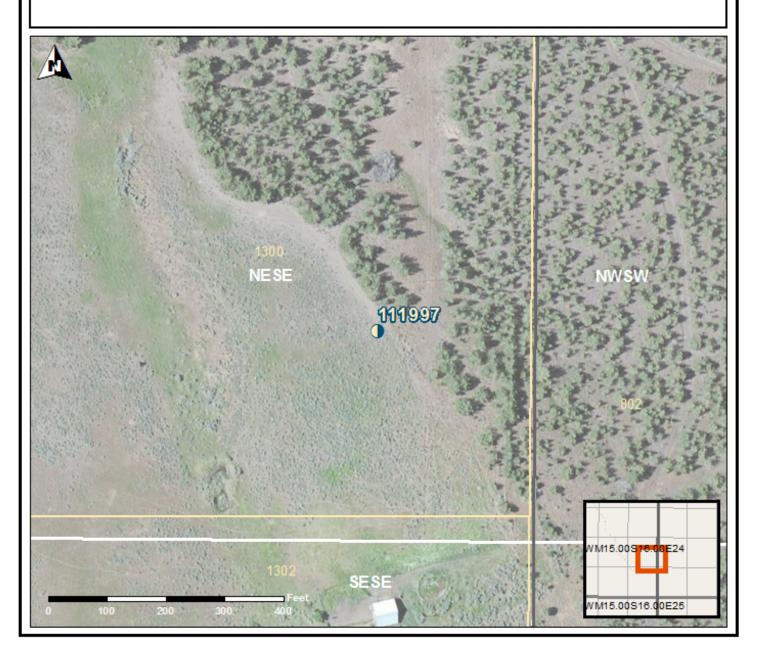

**CROO 54523** 

8/10/2017

Map of Hole

### STATE OF OREGON WELL LOCATION MAP

This map is supplemental to the WATER SUPPLY WELL REPORT

## LOCATION OF WELL

Latitude: 44.25162 Datum: WGS84 Longitude: -120.7477 Township/Range/Section/Quarter-Quarter Section: WM 15S 16E 24 NESE Address of Well: 6100 SE PAULINA HWY.

#### Oregon Water Resources Department 725 Summer St NE, Salem OR 97301 (503)986-0900



# Well Label: 111997 Printed: August 10, 2017

DISCLAIMER: This map is intended to represent the approximate location the well. It is not intended to be construed as survey accurate in any manner.

Provided by well constructor

