STATE OF OREGON
WATER SUPPLY WELL REPORT
(as required by ORS 537.545 & 537.765 and OAR 690-205-0210)

CROO 55717

11/1/2025

WELL I.D. LABEL# L 156384
START CARD # 1079385
ORIGINAL LOG #

(1) LAND OWNER

Owner Well I.D.
First Name SHAWN Last Name WHITE
Company
Address 2141 SE MELROSE DR
City PRINEVILLE State OR Zip 97754

(2) TYPE OF WORK

☒ New Well ☐ Deepening ☐ Conversion ☐ Alteration (complete 2a & 10) ☐ Abandonment(complete 5a)

(2a) PRE-ALTERATION

	Dia	+	From	To	Gauge	Stl	Plstc	Wld	Thrd
Casing:									

	Material	From	To	Amt	sacks/lbs
Seal:					

(3) DRILL METHOD

☐ Rotary Air ☐ Rotary Mud ☒ Cable ☐ Auger ☐ Cable Mud
☐ Reverse Rotary ☐ Other

(4) PROPOSED USE

☒ Domestic ☐ Irrigation ☐ Community
☐ Industrial/ Commercial ☐ Livestock ☐ Dewatering
☐ Thermal ☐ Injection ☐ Other

(5) BORE HOLE CONSTRUCTION

Special Standard ☐ (Attach copy)
Depth of Completed Well 95.00 ft.

BORE HOLE

Dia	From	To
12	0	18.5
6	18.5	95

SEAL

Material	From	To	Amt	sacks/lbs
Bentonite	0	18.5	19	S
		Calculated	12	
		Calculated		

Seal placement method: ☐ A ☐ B ☐ C ☐ D ☐ E ☒ Other: POURED AND TAGGED
Backfill placed from 0 ft. to 18.5 ft. Material BENTONITE
Filter pack from ft. to ft. Material Size
Explosives used: ☐ Type Amount
Seal Placement Begin Date 9/3/2025 Begin Time 09 00

(5a) ABANDONMENT USING UNHYDRATED BENTONITE

Proposed Amount Actual Amount

(6) CASING/LINER

C/L	Dia	+	From	To	Gauge	Mat. Type	Wld	Thrd	Shoe	Shoe Location
C	6	☒	1.5	44	0.250	ST	☒			
L	5		5	95	0.188	ST	☒			

Temp casing ☐ Yes Dia From + To

(7) PERFORATIONS/SCREENS

Perforations Method
Screens Type Johnson Material Stainless

Perf/ Screen	Casing/ Liner	Screen Dia	From	To	Scrn/slot width	Slot length	# of slots	Tele/ Pipe size
Screen	Liner	5	85	95	.01			Telescope

(8) WELL TESTS: Minimum testing time is 1 hour

Type of Test	Yield (gal/min)	Drawdown	Drill Stem/ Pump Depth	Duration (hr)
Pump	20	11	95	6

Temperature 55 °F Lab analysis ☐ Yes By
Water quality concerns? ☐ Yes (describe below) TDS amount 250 ppm

From	To	Description	Amount	Units

(9) LOCATION OF WELL (legal description)

County CROOK Twp 15.00 S N/S Range 16.00 E E/W WM
Sec 4 NE 1/4 of the SW 1/4 Tax Lot 02300
Tax Map Number Lot 0230
Lat ° ' " or 44.29527000 DMS or DD
Long ° ' " or -120.82135000 DMS or DD
◉ Street address of well ○ Nearest address
2141 SE MELROSE DR, PRINEVILLE, OR 97754

(10) STATIC WATER LEVEL

	Date	SWL(psi)	+	SWL(ft)
Existing Well / Pre-Alteration				
Completed Well	9/9/2025			24

Flowing Artesian? ☐ Dry Hole? ☐

WATER BEARING ZONES Depth water was first found 24.00

SWL Date	From	To	Est Flow	SWL(psi)	+	SWL(ft)
9/8/2025	24	95	20			24

(11) WELL LOG

Ground Elevation 2909.15 FT

Material	From	To
Top Soil	0	1
Tan Clay	1	24
Tan Clay with course Tan Sand WB	24	40
Black Sand With Large Gravel	40	70
Course Black Sand WB	70	95

Construction Begin Date 9/3/2025 Begin Time 09 00 End Date 9/9/2025

(unbonded) Water Well Constructor Certification

I certify that the work I performed on the construction, deepening, alteration, or abandonment of this well is in compliance with Oregon water supply well construction standards. Materials used and information reported above are true to the best of my knowledge and belief.

License Number Date

Signed

(bonded) Water Well Constructor Certification

I accept responsibility for the construction, deepening, alteration, or abandonment work performed on this well during the construction dates reported above. All work performed during this time is in compliance with Oregon water supply well construction standards. This report is true to the best of my knowledge and belief.

License Number 2096 Date 11/1/2025

Signed LANCE SINGHOSE (E-filed)
Drilling Company: Aqua Works Well Service

ORIGINAL - WATER RESOURCES DEPARTMENT

THIS REPORT MUST BE SUBMITTED TO THE WATER RESOURCES DEPARTMENT WITHIN 30 DAYS OF COMPLETION OF WORK Form Version:
New exempt use wells must be submitted with a map and recording fee.

WATER SUPPLY WELL REPORT - continuation page

CROO 55717

11/1/2025

WELL I.D. LABEL# L 156384

START CARD # 1079385

ORIGINAL LOG #

(2a) PRE-ALTERATION

Dia	+	From	To	Gauge	Stl	Plstc	Wld	Thrd

Material	From	To	Amt	sacks/lbs

(5) BORE HOLE CONSTRUCTION

BORE HOLE Dia	From	To

SEAL Material	From	To	Amt	sacks/lbs
		Calculated		
		Calculated		
		Calculated		
		Calculated		

FILTER PACK

From	To	Material	Size

(6) CASING/LINER

C/L	Dia	+	From	To	Gauge	Mat. Type	Wld	Thrd	Shoe	Shoe Location

(7) PERFORATIONS/SCREENS

Perf/ Screen	Casing/ Liner	Screen Dia	From	To	Scrn/slot width	Slot length	# of slots	Tele/ Pipe size

(8) WELL TESTS: Minimum testing time is 1 hour

Type of Test	Yield (gal/min)	Drawdown	Drill Stem/ Pump Depth	Duration (hr)

Water Quality Concerns

From	To	Description	Amount	Units

(10) STATIC WATER LEVEL

SWL Date	From	To	Est Flow	SWL(psi)	+	SWL(ft)

(11) WELL LOG

Material	From	To

WATER SUPPLY WELL REPORT - Map with location identified must be attached and shall include an approximate scale and north arrow

CROO 55717

11/1/2025

Map of Hole

STATE OF OREGON
WELL LOCATION MAP

This map is supplemental to the WATER SUPPLY WELL REPORT

Oregon Water Resources Department
725 Summer St NE, Salem OR 97301
(503)986-0900


LOCATION OF WELL
Latitude: 44.29523000 Datum: WGS84
Longitude: -120.82105000
Township/Range/Section/Quarter-Quarter Section:
WM15.00S16.00E4NESW
Address of Well:
2141 SE MELROSE DR, PRINEVILLE, OR 97754

Well Label: 156384

Printed: November 1, 2025

DISCLAIMER: This map is intended to represent the approximate location the well. It is not intended to be construed as survey accurate in any manner.

Provided by well constructor

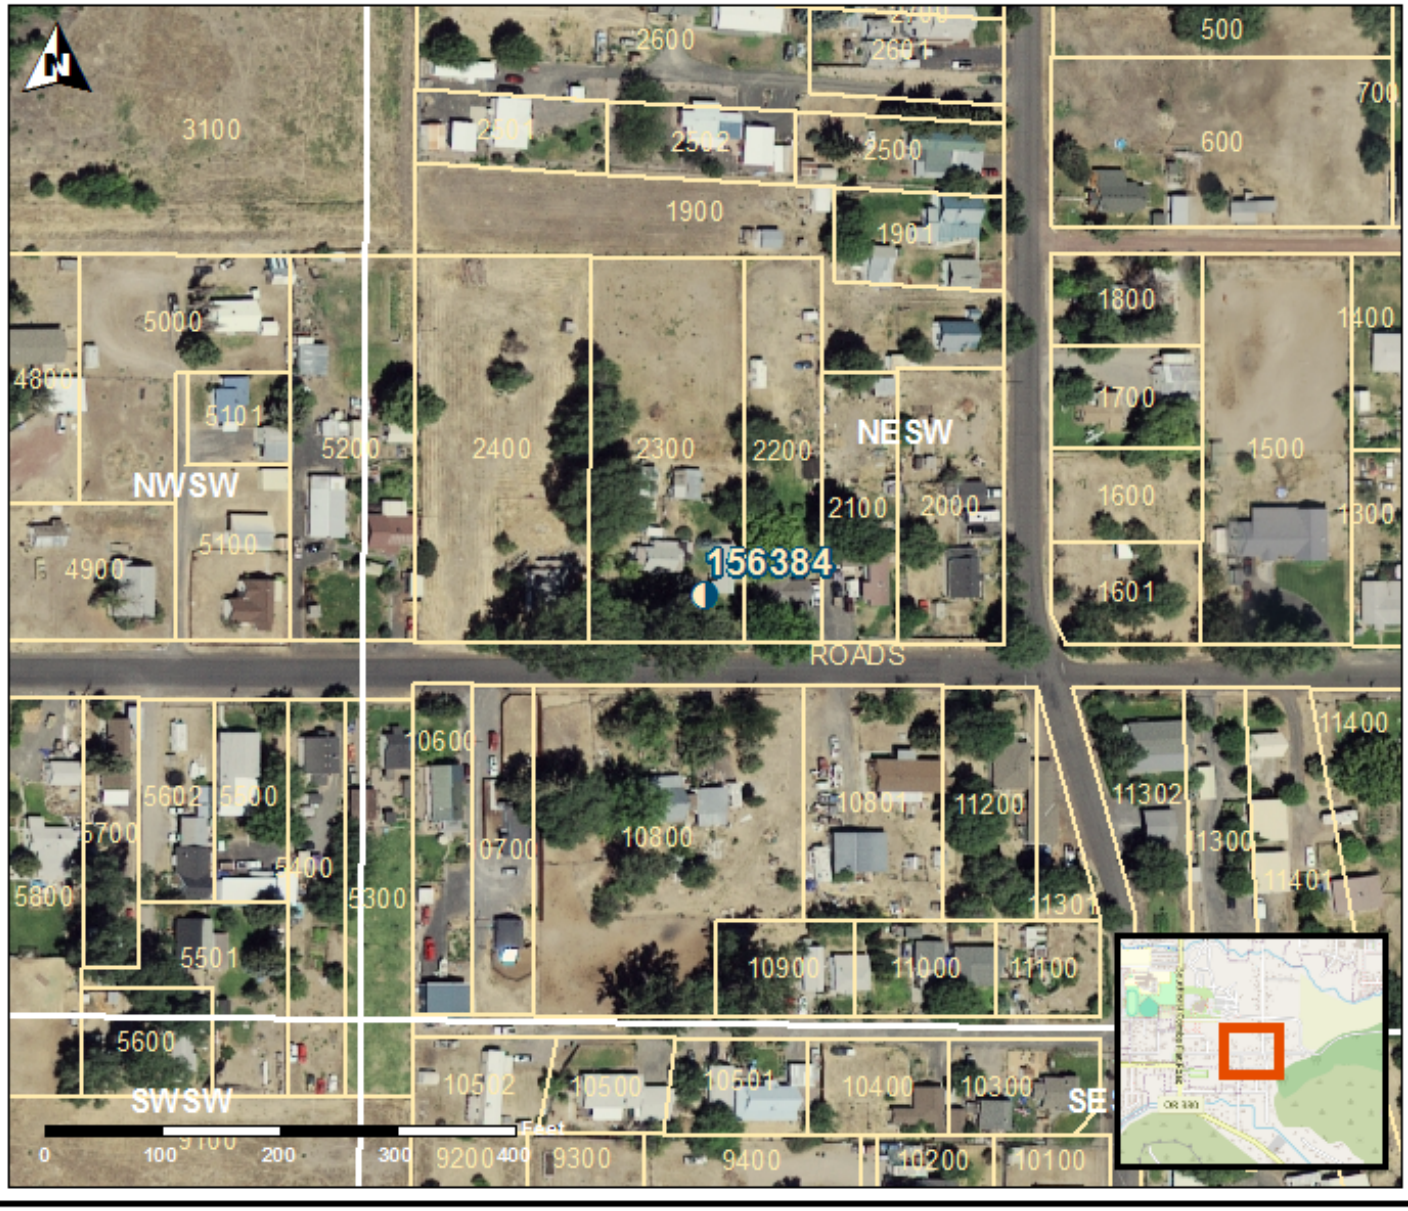

WATER SUPPLY WELL REPORT - continuation page

CROO 55717

11/1/2025

Map of Hole

STATE OF OREGON
WELL LOCATION MAP

This map is supplemental to the WATER SUPPLY WELL REPORT

Oregon Water Resources Department
725 Summer St NE, Salem OR 97301
(503)986-0900

LOCATION OF WELL

Latitude: 44.29527 Datum: WGS84

Longitude: -120.82135

Township/Range/Section/Quarter-Quarter Section:
WM15.00S16.00E4NESW

Address of Well:
2141 SE MELROSE DR, PRINEVILLE, OR 97754

Well Label: 156384

Printed: November 1, 2025

DISCLAIMER: This map is intended to represent the approximate location the well. It is not intended to be construed as survey accurate in any manner.

Provided by well constructor

