

STATE OF OREGON
WATER SUPPLY WELL REPORT

CROO 55806

WELL I.D. LABEL# L

Page 1 of 3

START CARD #

ORIGINAL LOG #

159811

1082761

(as required by ORS 537.545 & 537.765 and OAR 690-205-0210)

8/11/2026

(1) LAND OWNER

Owner Well I.D.

First Name BOWDEY

Last Name DYE

Company

Address 5049 SE GOBLE DR.

City PRINEVILLE

State OR

Zip 97754

(2) TYPE OF WORK

☒ New Well

☐ Deepening

☐ Conversion

☐ Alteration (complete 2a & 10)

☐ Abandonment (complete 5a)

(2a) PRE-ALTERATION

Casing: Dia + From To Gauge Stl Plstc Wld Thrd
Material From To Amt sacks/lbs
Seal: Material From To Amt sacks/lbs

(3) DRILL METHOD

☒ Rotary Air ☐ Rotary Mud ☐ Cable ☐ Auger

☐ Reverse Rotary ☐ Other

(4) PROPOSED USE

☒ Domestic

☐ Irrigation

☐ Community

☐ Industrial/ Commercial

☐ Livestock

☐ Dewatering

☐ Thermal ☐ Injection ☐ Other

(5) BORE HOLE CONSTRUCTION

Special Standard ☐ (Attach copy)

Depth of Completed Well 392.00 ft.

BORE HOLE				SEAL			
Dia	From	To	Material	From	To	Amt	sacks/lbs
12	0	18.5	Bentonite	0	18.5	14	S
8	18.5	392			Calculated	10.49	
					Calculated		

Seal placement method: ☐ A ☐ B ☐ C ☐ D ☐ E ☒ Other: POURED DRY

Backfill placed from ft. to ft. Material

Filter pack from ft. to ft. Material Size

Explosives used: ☐ Type Amount

Seal Placement Begin Date 7/7/2026 Begin Time 12 45

(5a) ABANDONMENT USING UNHYDRATED BENTONITE

Proposed Amount

Actual Amount

(6) CASING/LINER

C/L	Dia	+	From	To	Gauge	Mat. Type	Wld	Thrd	Shoe	Location
C	8	☒	1.5	18.5	0.250	ST		☒		
L	4.5		4	392	Sch40	PL		☒		

Temp casing ☐ Yes Dia From + To

(7) PERFORATIONS/SCREENS

Perforations Method Factory

Screens Type

Material

Perf/ Screen	Casing/ Liner	Screen Dia	From	To	Scrm/slot width	Slot length	# of slots	Tele/ Pipe size
Perf	Liner	4.5	292	392	.032	3	16200	

(8) WELL TESTS: Minimum testing time is 1 hour

Type of Test	Yield (gal/min)	Drawdown	Drill Stem/ Pump Depth	Duration (hr)
Air	50		392	1

Temperature 62 °F Lab analysis ☐ Yes By

Water quality concerns? ☐ Yes (describe below) TDS amount 142 ppm

From	To	Description	Amount	Units

(9) LOCATION OF WELL (legal description)

County CROOK Twp 15.00 S N/S Range 16.00 E E/W WM

Sec 35 SE 1/4 of the NW 1/4 Tax Lot 4200

Tax Map Number Lot

Lat ° ' " or 44.22767500 DMS or DD

Long ° ' " or -120.77917000 DMS or DD

☒ Street address of well ☐ Nearest address

5049 SE GOBLE DR., PRINEVILLE, OR 97754

(10) STATIC WATER LEVEL

	Date	SWL (psi)	+	SWL (ft)
Existing Well / Pre-Alteration				
Completed Well	7/8/2026			227
Flowing Artesian? ☐ Dry Hole? ☐				

WATER BEARING ZONES

Depth water was first found 286.00

SWL Date	From	To	Est Flow	SWL (psi)	+	SWL (ft)
7/8/2026	286	392	50			227

(11) WELL LOG

Ground Elevation 4110.30 FT

Material	From	To
Top Soil	0	1
Broken Rock	1	3
Hard Grey Clay Stone	3	5
Hard Dark Brown Clay Stone	5	28
Grey Basalt	28	108
Multi-Colored Conglomerate	108	115
Grey Basalt	115	176
Grey Clay Stone	176	193
Grey Basalt	193	205
Black Cinder	205	217
Grey Basalt	217	283
Grey Basalt w/Grey Clay Seams	283	286
Broken Grey Basalt	286	310
Grey Basalt	310	328
Broken Grey Basalt	328	392

Construction

Begin Date 7/7/2026 Begin Time 07 30 End Date 7/8/2026

(unbonded) Water Well Constructor Certification

I certify that the work I performed on the construction, deepening, alteration, or abandonment of this well is in compliance with Oregon water supply well construction standards. Materials used and information reported above are true to the best of my knowledge and belief.

License Number Date

Signed

(bonded) Water Well Constructor Certification

I accept responsibility for the construction, deepening, alteration, or abandonment work performed on this well during the construction dates reported above. All work performed during this time is in compliance with Oregon water supply well construction standards. This report is true to the best of my knowledge and belief.

License Number 2076 Date 8/11/2026

Signed GLENN DAVIS (E-filed)

Drilling Company:

ORIGINAL - WATER RESOURCES DEPARTMENT

THIS REPORT MUST BE SUBMITTED TO THE WATER RESOURCES DEPARTMENT WITHIN 30 DAYS OF COMPLETION OF WORK Form Version:

New exempt use wells must be submitted with a map and recording fee.

WATER SUPPLY WELL REPORT - Map with location identified must be attached and shall include an approximate scale and north arrow

CROO 55806

8/11/2026

Map of Hole

STATE OF OREGON WELL LOCATION MAP

This map is supplemental to the WATER SUPPLY WELL REPORT

Oregon Water Resources Department

725 Summer St NE, Salem OR 97301
(503)986-0900



LOCATION OF WELL

Latitude: 44.22767500 Datum: WGS84

Longitude: -120.77917000

Township/Range/Section/Quarter-Quarter Section:
WM15.00S16.00E35SENW

Address of Well:


5049 SE GOBLE DR., PRINEVILLE, OR 97754

Well Label: 159811

Printed: August 11, 2026

DISCLAIMER: This map is intended to represent the approximate location the well. It is not intended to be construed as survey accurate in any manner.

Provided by well constructor

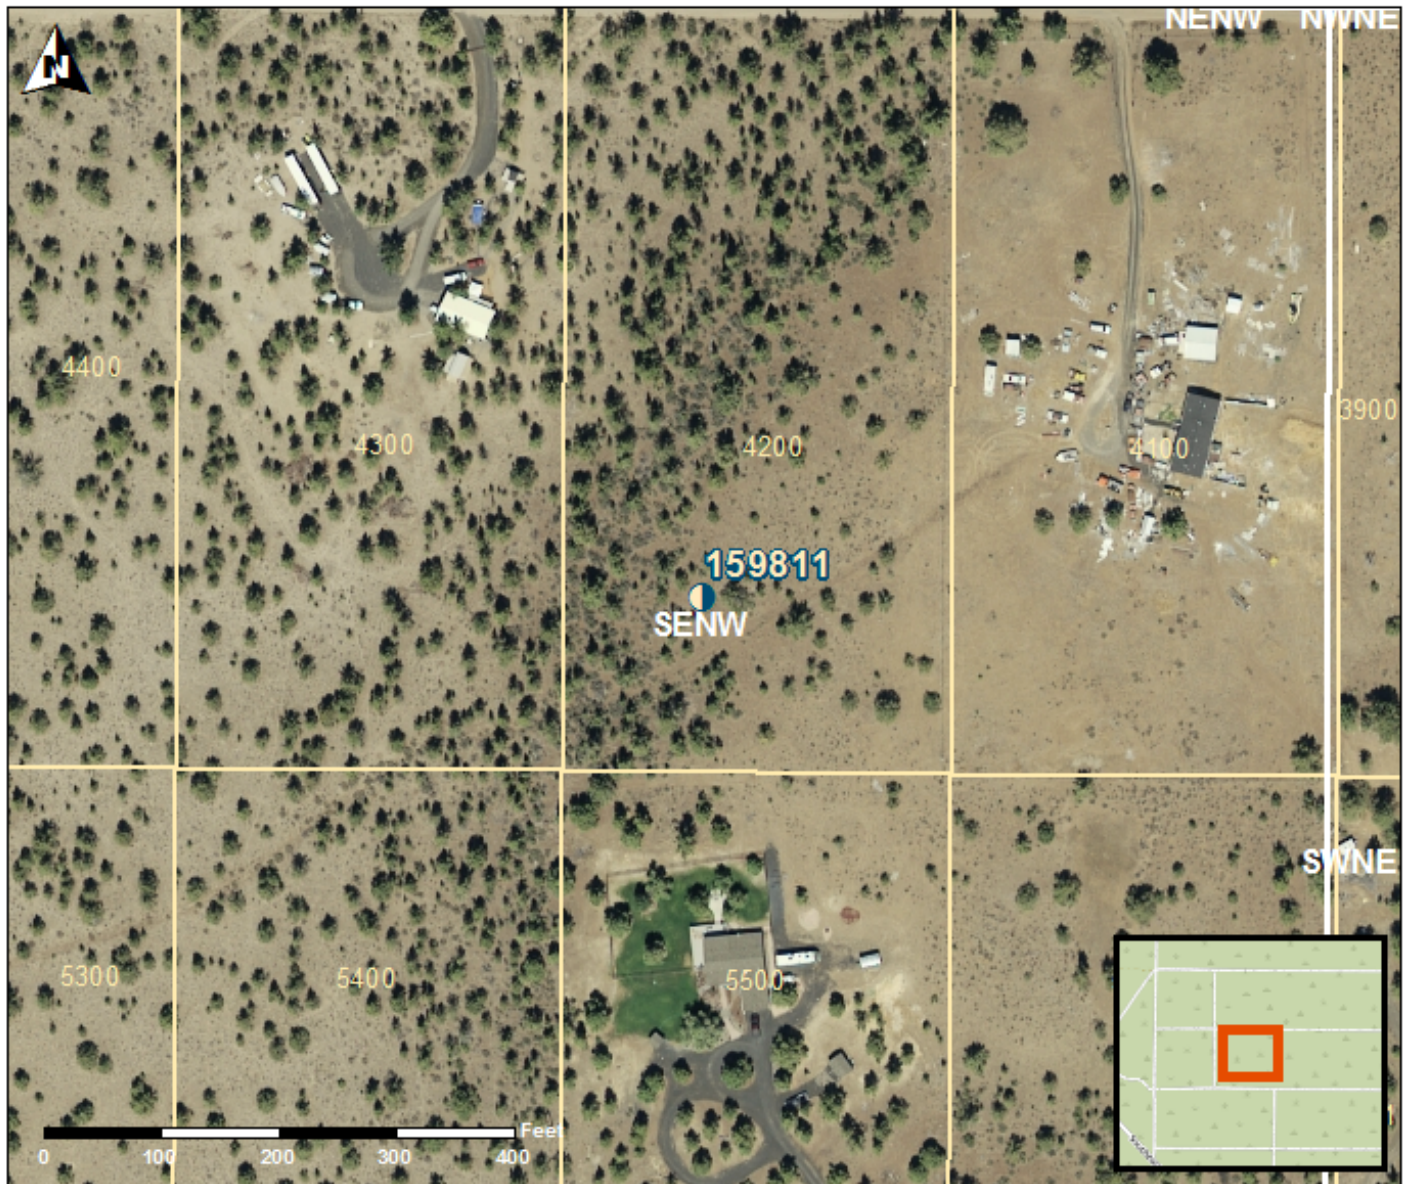

8/11/2026

Map of Hole

