STATE OF OREGON
WATER SUPPLY WELL REPORT
(as required by ORS 537.545 & 537.765 and OAR 690-205-0210)

CROO 55812
8/31/2026

WELL I.D. LABEL# L	23672
START CARD #	1083189
ORIGINAL LOG #	CROOK 50520

(1) LAND OWNER

Owner Well I.D.

First Name PAMELA & CHRISTOPHEI Last Name JOHNSON
Company
Address 13555 SE NAVAJO RD
City PRINEVILLE State OR Zip 97754

(2) TYPE OF WORK

☐ New Well ☒ Deepening ☐ Conversion
☐ Alteration (complete 2a & 10) ☐ Abandonment(complete 5a)

(2a) PRE-ALTERATION

	Dia	+	From	To	Gauge	Stl	Plstc	Wld	Thrd
Casing:									

	Material	From	To	Amt	sacks/lbs
Seal:					

(3) DRILL METHOD

☒ Rotary Air ☐ Rotary Mud ☐ Cable ☐ Auger
☐ Reverse Rotary ☐ Other

(4) PROPOSED USE

☒ Domestic ☐ Irrigation ☐ Community
☐ Industrial/ Commercial ☐ Livestock ☐ Dewatering
☐ Thermal ☐ Injection ☐ Other

(5) BORE HOLE CONSTRUCTION

Special Standard ☐ (Attach copy)

Depth of Completed Well 441.00 ft.

BORE HOLE Dia	From	To	SEAL Material	From	To	Amt	sacks/lbs
6	0	450					
					Calculated		
					Calculated		

Seal placement method: ☐ A ☐ B ☐ C ☐ D ☐ E ☐ Other:
Backfill placed from ft. to ft. Material
Filter pack from ft. to ft. Material Size
Explosives used: ☐ Type Amount
Seal Placement Begin Date Begin Time

(5a) ABANDONMENT USING UNHYDRATED BENTONITE

Proposed Amount Actual Amount

(6) CASING/LINER

C/L	Dia	+	From	To	Gauge	Mat. Type	Wld	Thrd	Shoe	Shoe Location

Temp casing ☐ Yes Dia From + ☐ To

(7) PERFORATIONS/SCREENS

Perforations Method
Screens Type Material

Perf/ Screen	Casing/ Liner	Screen Dia	From	To	Scrn/slot width	Slot length	# of slots	Tele/ Pipe size

(8) WELL TESTS: Minimum testing time is 1 hour

Type of Test	Yield (gal/min)	Drawdown	Drill Stem/ Pump Depth	Duration (hr)
Air	15		436	1

Temperature 59 °F Lab analysis ☐ Yes By
Water quality concerns? ☐ Yes (describe below) TDS amount 144 ppm

From	To	Description	Amount	Units

(9) LOCATION OF WELL (legal description)

County CROOK Twp 16.00 S N/S Range 16.00 E E/W WM
Sec 14 NW 1/4 of the SW 1/4 Tax Lot 3300
Tax Map Number Lot
Lat ° ' " or 44.17913120 DMS or DD
Long ° ' " or -120.78766040 DMS or DD
◉ Street address of well ◯ Nearest address
13555 SE NAVAJO RD, PRINEVILLE, OR 97754

(10) STATIC WATER LEVEL

	Date	SWL(psi)	+	SWL(ft)
Existing Well / Pre-Alteration	8/11/2026			355
Completed Well	8/11/2026			298

Flowing Artesian? ☐ Dry Hole? ☐

WATER BEARING ZONES Depth water was first found 298.00

SWL Date	From	To	Est Flow	SWL(psi)	+	SWL(ft)
8/11/2026	298	441	15			298

(11) WELL LOG

Ground Elevation 3765.56 FT

Material	From	To
CROO 50520 Clean out	0	430
Multi colored diced gravels	0	430
Brown/ gray clay congl	430	450

Construction
Begin Date 8/11/2026 Begin Time 10 15 End Date 8/11/2026

(unbonded) Water Well Constructor Certification

I certify that the work I performed on the construction, deepening, alteration, or abandonment of this well is in compliance with Oregon water supply well construction standards. Materials used and information reported above are true to the best of my knowledge and belief.

License Number 1970 Date 8/12/2026

Signed NEIL FAGEN (E-filed)

(bonded) Water Well Constructor Certification

I accept responsibility for the construction, deepening, alteration, or abandonment work performed on this well during the construction dates reported above. All work performed during this time is in compliance with Oregon water supply well construction standards. This report is true to the best of my knowledge and belief.

License Number 1970 Date 8/31/2026

Signed NEIL FAGEN (E-filed)

Drilling Company: 541-548-1245

WATER SUPPLY WELL REPORT - continuation page

CROO 55812

8/31/2026

WELL I.D. LABEL# L 23672
START CARD # 1083189
ORIGINAL LOG # CROOK 50520

(2a) PRE-ALTERATION

Dia	+	From	To	Gauge	Stl	Plstc	Wld	Thrd

Material	From	To	Amt	sacks/lbs

(5) BORE HOLE CONSTRUCTION

BORE HOLE Dia	From	To	SEAL Material	From	To	Amt	sacks/lbs
					Calculated		
					Calculated		
					Calculated		
					Calculated		

FILTER PACK

From	To	Material	Size

(6) CASING/LINER

C/L	Dia	+	From	To	Gauge	Mat. Type	Wld	Thrd	Shoe	Shoe Location

(7) PERFORATIONS/SCREENS

Perf/ Screen	Casing/ Liner	Screen Dia	From	To	Scrn/slot width	Slot length	# of slots	Tele/ Pipe size

(8) WELL TESTS: Minimum testing time is 1 hour

Type of Test	Yield (gal/min)	Drawdown	Drill Stem/ Pump Depth	Duration (hr)

Water Quality Concerns

From	To	Description	Amount	Units

(10) STATIC WATER LEVEL

SWL Date	From	To	Est Flow	SWL(psi)	+	SWL(ft)

(11) WELL LOG

Material	From	To

WATER SUPPLY WELL REPORT - Map with location identified must be attached and shall include an approximate scale and north arrow

CROO 55812

8/31/2026

Map of Hole

STATE OF OREGON
WELL LOCATION MAP

This map is supplemental to the WATER SUPPLY WELL REPORT

Oregon Water Resources Department
725 Summer St NE, Salem OR 97301
(503)986-0900

LOCATION OF WELL

Latitude: 44.17913120 Datum: WGS84
Longitude: -120.78766040
Township/Range/Section/Quarter-Quarter Section:
WM16.00S16.00E14NWSW
Address of Well:
13555 SE NAVAJO RD, PRINEVILLE, OR 97754

Well Label: 23672

Printed: August 12, 2026

DISCLAIMER: This map is intended to represent the approximate location the well. It is not intended to be construed as survey accurate in any manner.
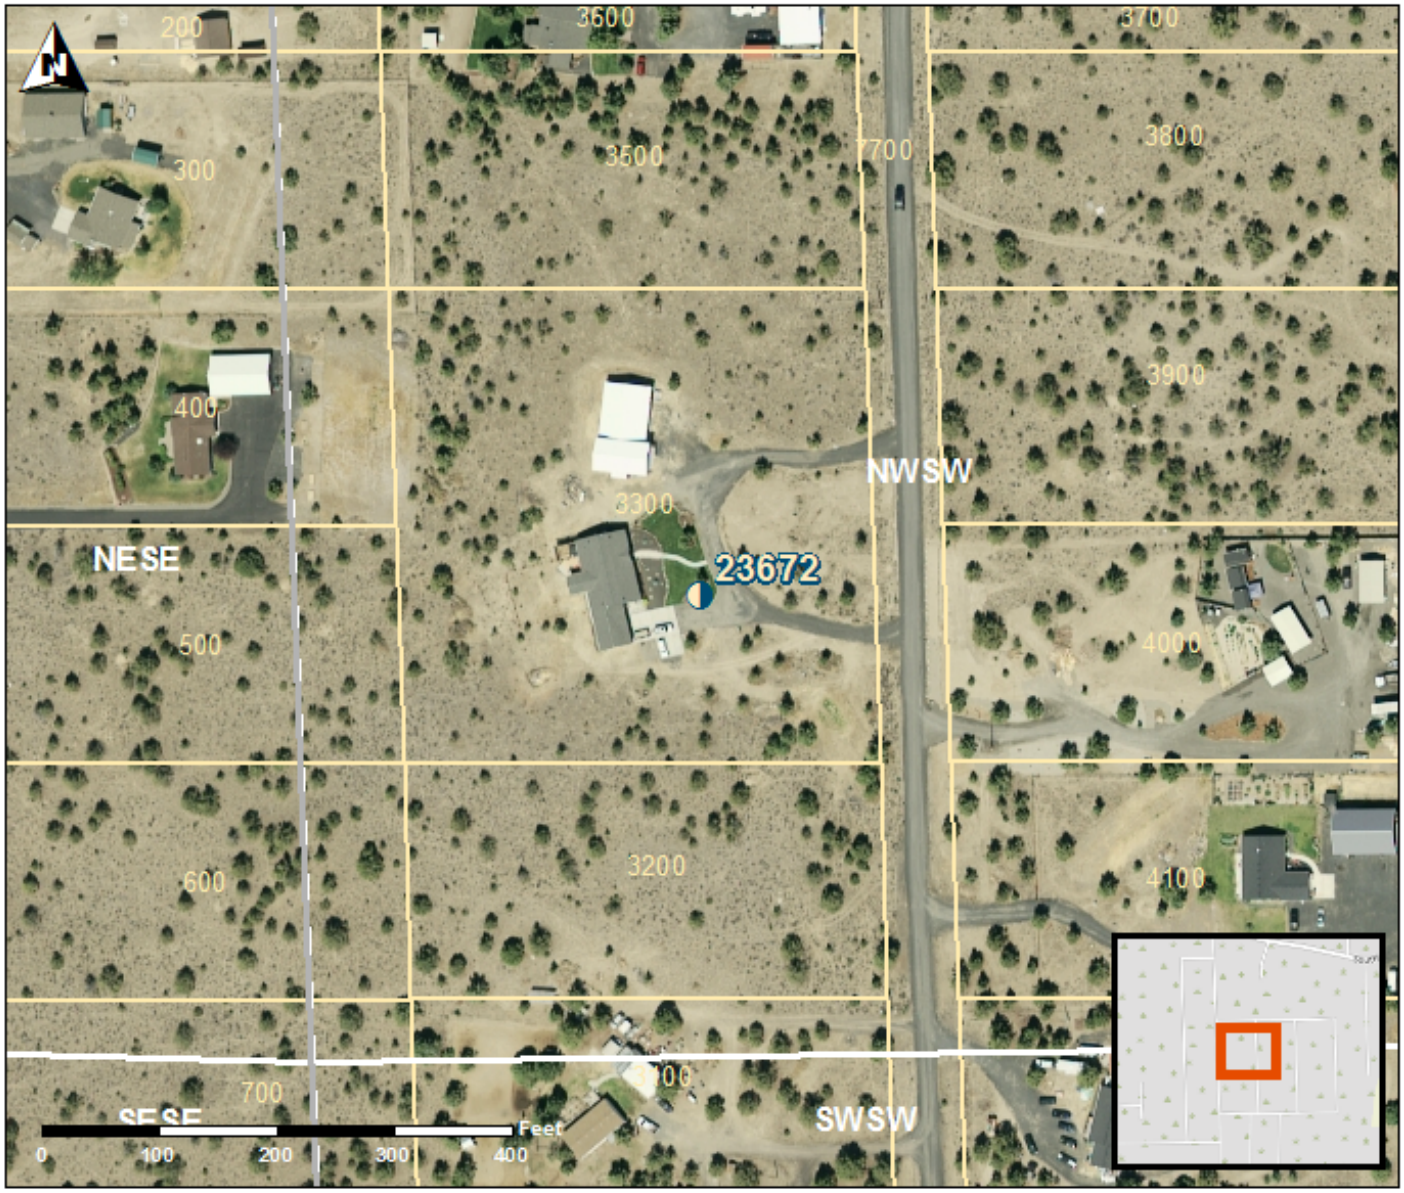
Provided by well constructor