

STATE ENGINEER  
Salem, Oregon

CROOK  
959

# Well Record

STATE WELL NO. 14/15-17N(1)  
COUNTY Crook  
APPLICATION NO. U-612

OWNER: Burns & Alice Montgomery

MAILING ADDRESS: Route 1, Box 1316


LOCATION OF WELL: Owner's No.

CITY AND STATE: Prineville, Oregon

97754

SW 1/4 SW 1/4 Sec. 17 T. 14 N. S. R. 15 E. W., W.M.

Bearing and distance from section or subdivision corner 76' N. & 209' E of SW cor. Sec. 17

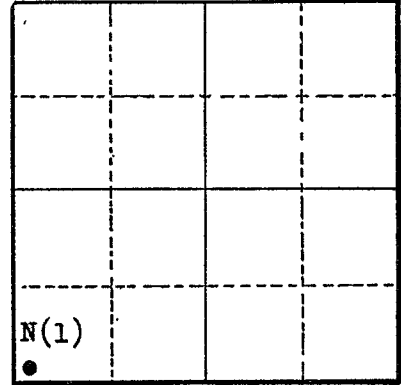

Section 17

Altitude at well

TYPE OF WELL: Drilled Date Constructed

Depth drilled 24 Depth cased

### CASING RECORD:

16-inch

### FINISH:

### AQUIFERS:

### WATER LEVEL:

6 feet below land surface, spring 1963

PUMPING EQUIPMENT: Type H.P.  
Capacity 160 G.P.M.

### WELL TESTS:

Drawdown ft. after hours G.P.M.  
Drawdown ft. after hours G.P.M.

USE OF WATER Irrigation Temp. °F., 19

SOURCE OF INFORMATION U-612

DRILLER or DIGGER

### ADDITIONAL DATA:

Log Water Level Measurements Chemical Analysis Aquifer Test

### REMARKS: