

STATE ENGINEER
Salem, Oregon

CROO
9101

OBSERVATION WELL
Well Record


STATE WELL NO. 14/15-20dda
COUNTY CROOK
APPLICATION NO. 8-85

OWNER: BOSTON CATTLE CO.

MAILING ADDRESS: PRINEVILLE, ORE.
CITY AND STATE: 97754

LOCATION OF WELL: Owner's No. _____
SE 1/4 NE 1/4 Sec. 20 T. 14 N. S., R. 15 E. W.M.

Bearing and distance from section or subdivision corner _____

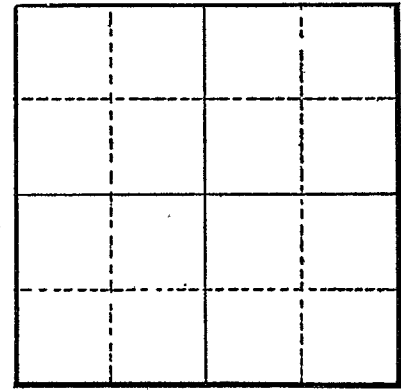

Section 20

Altitude at well _____

TYPE OF WELL: DRILLED Date Constructed _____

Depth drilled _____ Depth cased _____

CASING RECORD: _____

FINISH: _____

AQUIFERS: _____

WATER LEVEL: 9.88 (11-22-68)

PUMPING EQUIPMENT: Type _____ H.P. _____
Capacity _____ G.P.M.

WELL TESTS:
Drawdown _____ ft. after _____ hours _____ G.P.M.
Drawdown _____ ft. after _____ hours _____ G.P.M.

USE OF WATER UNUSED Temp. _____ °F. _____, 19

SOURCE OF INFORMATION _____

DRILLER or DIGGER _____

ADDITIONAL DATA:
Log NA Water Level Measurements Chemical Analysis _____ Aquifer Test _____

REMARKS: _____