

STATE ENGINEER
Salem, Oregon

CRUO
968

Well Record

STATE WELL NO. 14/15-20R(1)
COUNTY Crook
APPLICATION NO.

OWNER: Mr. Slavin


MAILING
ADDRESS:

LOCATION OF WELL: Owner's No.

CITY AND
STATE:

..... 1/4 1/4 Sec. T. N. E.
..... S., R. W., W.M.

Bearing and distance from section or subdivision
corner

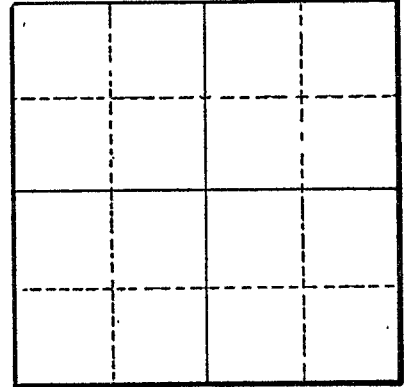

Section

Altitude at well

TYPE OF WELL: Dug Date Constructed 1949

Depth drilled 20+ Depth cased

CASING RECORD:

240x300

FINISH:

AQUIFERS:

Unconfined

WATER LEVEL:

14 feet below land surface on April 4, 1950

PUMPING EQUIPMENT: Type Turbine H.P.
Capacity 500 G.P.M.

WELL TESTS:

Drawdown ft. after hours G.P.M.
Drawdown ft. after hours G.P.M.

USE OF WATER Irrigation Temp. °F., 19.....

SOURCE OF INFORMATION USGS

DRILLER or DIGGER

ADDITIONAL DATA:

Log Water Level Measurements Chemical Analysis Aquifer Test

REMARKS: