

STATE ENGINEER  
Salem, Oregon

986

# Well Record


STATE WELL NO. 14/15-23R(1)  
COUNTY Crook  
APPLICATION NO. U-142

OWNER: Pine Products Corp.

MAILING ADDRESS:  
CITY AND STATE: Prineville, Oregon

LOCATION OF WELL: Owner's No. SE 1/4 SE 1/4 Sec. 23 T. 14 N. S. R. 15 W., W.M.

Bearing and distance from section or subdivision corner

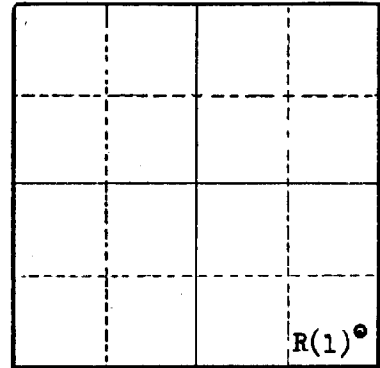

Section 23

Altitude at well

TYPE OF WELL: Drilled Date Constructed

Depth drilled 230 Depth cased 6

### CASING RECORD:

### FINISH:

### AQUIFERS:

### WATER LEVEL:

PUMPING EQUIPMENT: Type H.P. 3  
Capacity 68 G.P.M.

### WELL TESTS:

Drawdown ft. after hours G.P.M.  
Drawdown ft. after hours G.P.M.

USE OF WATER Industrial Temp. 65 °F. January 29, 1949

SOURCE OF INFORMATION U-142, U.S.G.S. report

DRILLER or DIGGER

### ADDITIONAL DATA:

Log Water Level Measurements Chemical Analysis Aquifer Test

### REMARKS: