

STATE ENGINEER
Salem, Oregon

CROOK
988

Well Record

STATE WELL NO. 14/15-23F(1)
COUNTY Crook
APPLICATION NO.

OWNER: Claude F. Williams


MAILING ADDRESS: 97754

LOCATION OF WELL: Owner's No.

CITY AND STATE: Prineville, Oregon

SE 1/4 NW 1/4 Sec. 23 T. 14 N. S. R. 15 E. W. W.M.

Bearing and distance from section or subdivision corner S 46° 30' E 2514' of NW cor. Sec. 23

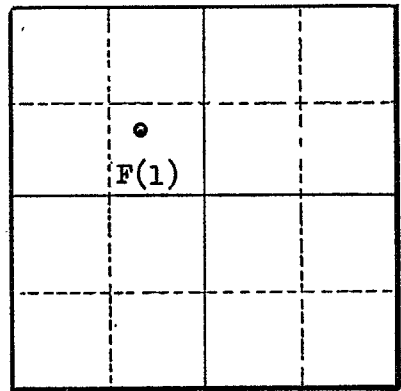

Section 23

Altitude at well

TYPE OF WELL: Drilled Date Constructed 1950

Depth drilled 345 Depth cased 320

CASING RECORD:

12-inch, set to 320 feet

FINISH:

Perforations from 298 to 312 feet

AQUIFERS:

Gravel from 306 to 312 feet

WATER LEVEL:

36 feet below land surface, 1950

PUMPING EQUIPMENT: Type _____ H.P. _____
Capacity _____ G.P.M. _____

WELL TESTS:
Drawdown 165 ft. after _____ hours pumping 65 G.P.M.
Drawdown _____ ft. after _____ hours _____ G.P.M.

USE OF WATER Irrigation, supplemental 52 temp. °F. _____, 19 _____

SOURCE OF INFORMATION
DRILLER or DIGGER Harty Bros.

ADDITIONAL DATA:
Log Water Level Measurements _____ Chemical Analysis _____ Aquifer Test _____

REMARKS:

