

STATE ENGINEER
Salem, Oregon

Well Record
CURR 000281

STATE WELL NO. 37/14W-6D
COUNTY Curry
APPLICATION NO. GR-4195

OWNER: J. C. Smith

MAILING
ADDRESS:

LOCATION OF WELL: Owner's No. #1

CITY AND


STATE: Gold Beach, Oregon

NW 1/4 NW 1/4 Sec. 6 T. 37 N. S. R. 14 E. W.M.

Bearing and distance from section or subdivision

corner 845 feet South and 1254 feet East of the

NW Corner, Section 6.

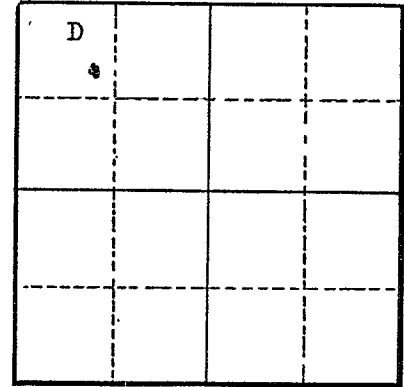

Section 6

Altitude at well 40 feet

TYPE OF WELL: Dug Date Constructed 1939

Depth drilled 40 feet Depth cased

CASING RECORD:

6-inch casing installed and well around casing packed with gravel

FINISH:

20 to 40 feet

AQUIFERS:

WATER LEVEL:

30 feet

PUMPING EQUIPMENT: Type Jacuzzi

H.P.

Capacity 100 G.P.M.

WELL TESTS:

Drawdown ft. after hours 10,000 gpd G.P.M.

Drawdown ft. after hours G.P.M.

USE OF WATER Municipal Temp. °F. 19

SOURCE OF INFORMATION GR-4073

DRILLER or DIGGER

ADDITIONAL DATA:

Log (NA) Water Level Measurements Chemical Analysis Aquifer Test

REMARKS: