

STATE ENGINEER
Salem, Oregon

CURR 000283 **Well Record**

STATE WELL NO. 37/14W-6D
COUNTY Curry
APPLICATION NO. GR-4217

OWNER: James C. Leith

MAILING
ADDRESS:

LOCATION OF WELL: Owner's No.


CITY AND
STATE:

Gold Beach, Oregon

NW 1/4 NW 1/4 Sec. 6 T. 37 N. S., R. 14 E. W., W.M.

Bearing and distance from section or subdivision

corner 602.7' S. & 880.8' E. of NW Cor. Sec. 6

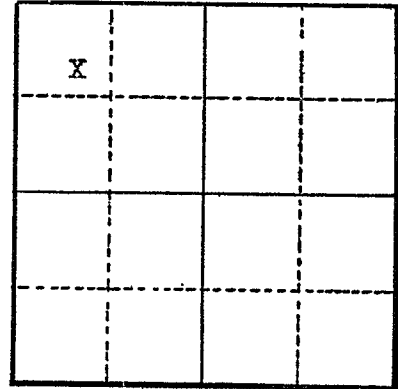

Altitude at well

TYPE OF WELL: Drilled Date Constructed 1948

Depth drilled 120 ft. Depth cased 120 ft.

Section 6

CASING RECORD:

6 inch casing set to 120 feet

FINISH:

Perforated from 40 to 120 feet

AQUIFERS:

WATER LEVEL:

90 feet below surface

PUMPING EQUIPMENT: Type Fairbanks Morse H.P. 5
Capacity G.P.M.

WELL TESTS:

Drawdown ft. after hours G.P.M.

Drawdown ft. after hours G.P.M.

USE OF WATER Domestic, Municipal Temp. °F. 19

SOURCE OF INFORMATION Well Registration Statement Cert. # GR-3761

DRILLER or DIGGER

ADDITIONAL DATA:

Log Water Level Measurements Chemical Analysis Aquifer Test

REMARKS: