

CURR  
50438

STATE OF OREGON  
WATER SUPPLY WELL REPORT  
(as required by ORS 537.765)

WELL I.D. # L 28403  
START CARD # 119706

Instructions for completing this report are on the last page of this form.

(1) OWNER: Well Number \_\_\_\_\_  
Name Port of Gold Beach  
Address P.O. Box 1126  
City Gold Beach State OR Zip 97444

(2) TYPE OF WORK  
 New Well  Deepening  Alteration (repair/recondition)  Abandonment

(3) DRILL METHOD:  
 Rotary Air  Rotary Mud  Cable  Auger  
 Other

(4) PROPOSED USE:  
 Domestic  Community  Industrial  Irrigation  
 Thermal  Injection  Livestock  Other

(5) BORE HOLE CONSTRUCTION:  
Special Construction approval  Yes  No Depth of Completed Well 60 ft.  
Explosives used  Yes  No Type \_\_\_\_\_ Amount \_\_\_\_\_

HOLE			SEAL			
Diameter	From	To	Material	From	To	Sacks or pounds
10"	0	20	Bentonite	0	30	15
6"	20	60				

How was seal placed: Method  A  B  C  D  E  
 Other Poured dry

Backfill placed from \_\_\_\_\_ ft. to \_\_\_\_\_ ft. Material \_\_\_\_\_  
Gravel placed from \_\_\_\_\_ ft. to \_\_\_\_\_ ft. Size of gravel \_\_\_\_\_

(6) CASING/LINER:

Diameter	From	To	Gauge	Steel	Plastic	Welded	Threaded
Casing: 6"	+1	59	.250	<input checked="" type="checkbox"/>	<input type="checkbox"/>	<input checked="" type="checkbox"/>	<input type="checkbox"/>
Liner: 4"	-5	60	.160	<input type="checkbox"/>	<input checked="" type="checkbox"/>	<input type="checkbox"/>	<input type="checkbox"/>

Final location of shoe(s)  
(7) PERFORATIONS/SCREENS:

Perforations Method \_\_\_\_\_  
 Screens Type \_\_\_\_\_ Material PVC

From	To	Slot size	Number	Diameter	Tele/pipe size	Casing	Liner
50	60	10,000		4x10		<input type="checkbox"/>	<input checked="" type="checkbox"/>

(8) WELL TESTS: Minimum testing time is 1 hour

Pump	Bailer	Air	Flowing
Yield gal/min	Drawdown	Drill stem at	Artesian Time
50		60	1 hr.

Temperature of water 50 Depth Artesian Flow Found \_\_\_\_\_  
Was a water analysis done?  Yes By whom \_\_\_\_\_  
Did any strata contain water not suitable for intended use?  Too little  
 Salty  Muddy  Odor  Colored  Other \_\_\_\_\_  
Depth of strata: \_\_\_\_\_

(9) LOCATION OF WELL by legal description:  
County Curry Latitude \_\_\_\_\_ Longitude \_\_\_\_\_  
Township 36S N or S Range 14W E or W. WM.  
Section 11 B 1/4 C 1/4  
Tax Lot 100 Lot \_\_\_\_\_ Block \_\_\_\_\_ Subdivision \_\_\_\_\_  
Street Address of Well (or nearest address) 96847 Jerry's Flat Rd  
Gold Beach, Oregon

(10) STATIC WATER LEVEL:  
32 ft. below land surface. Date 12/28/98  
Artesian pressure \_\_\_\_\_ lb. per square inch. Date \_\_\_\_\_

(11) WATER BEARING ZONES:

Depth at which water was first found 50'

From	To	Estimated Flow Rate	SWL
50'	60'	50	322

(12) WELL LOG:

Ground Elevation \_\_\_\_\_

Material	From	To	SWL
Brown Sandy Soil	0	3	
Blue Clay, Sand & Gravel	3	60	32

RECEIVED

DEC 29 1998

WATER RESOURCES DEPT.  
SALEM, OREGON

Date started 12/28/98 Completed 12/28/98  
(unbonded) Water Well Constructor Certification:

I certify that the work I performed on the construction, alteration, or abandonment of this well is in compliance with Oregon water supply well construction standards. Materials used and information reported above are true to the best of my knowledge and belief.



Signed \_\_\_\_\_ WWC Number \_\_\_\_\_ Date \_\_\_\_\_

(bonded) Water Well Constructor Certification:

I accept responsibility for the construction, alteration, or abandonment work performed on this well during the construction dates reported above. All work performed during this time is in compliance with Oregon water supply well construction standards. This report is true to the best of my knowledge and belief.

Signed \_\_\_\_\_ WWC Number 709 Date 12/28/98


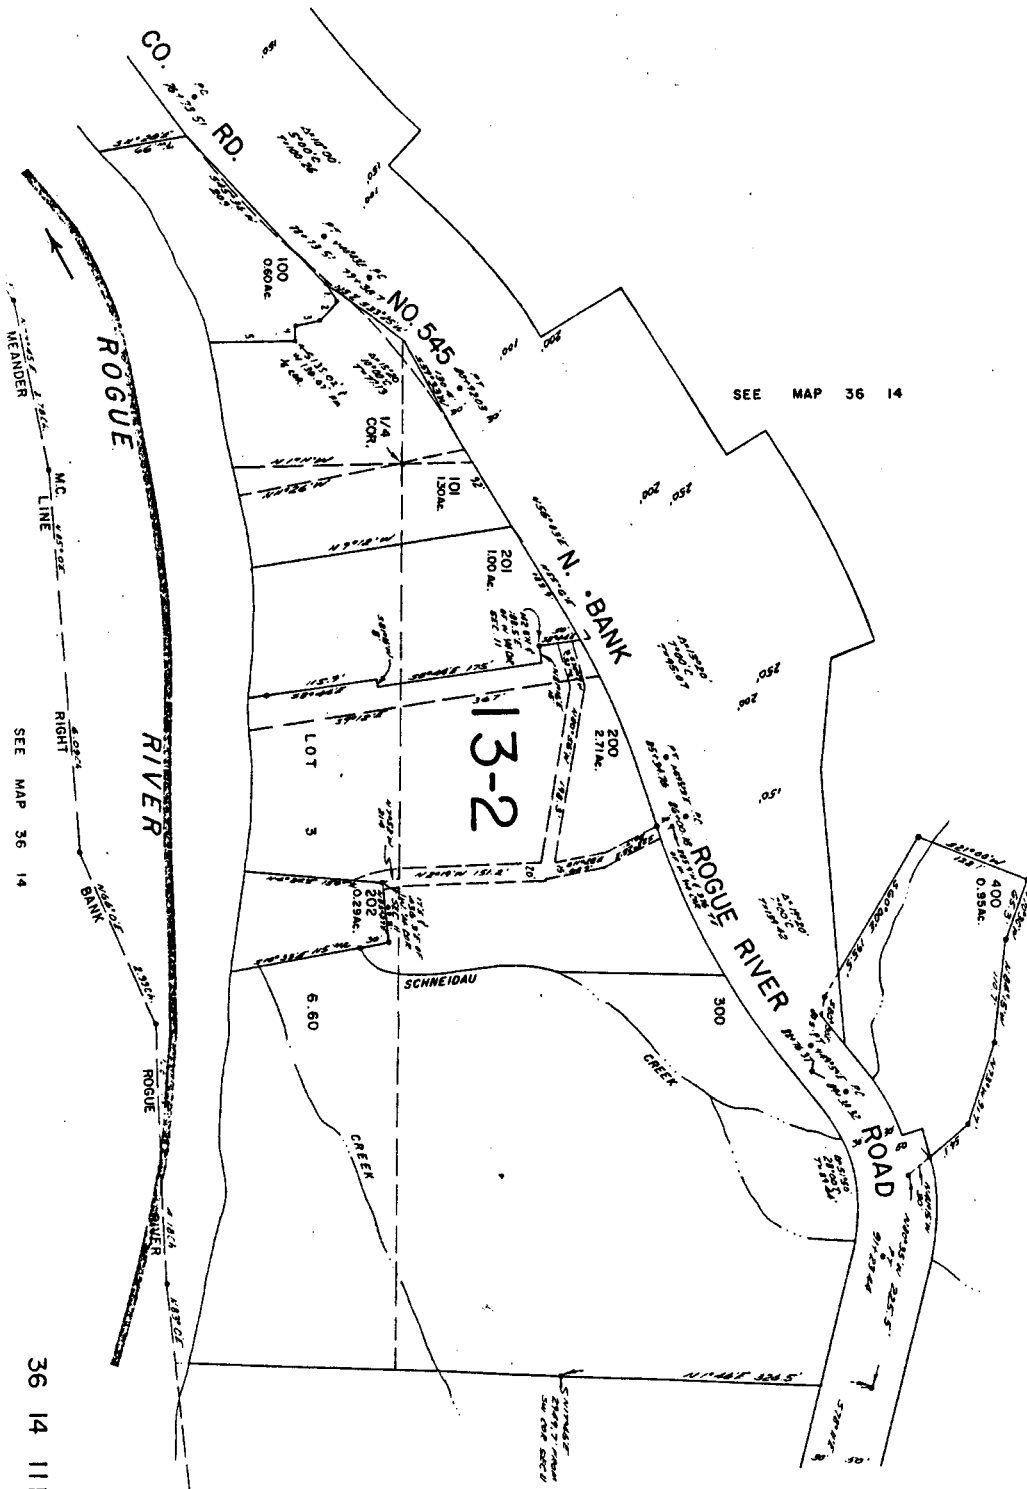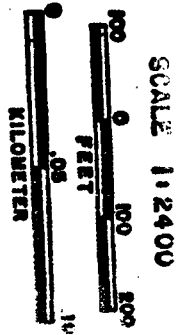

SEE MAP 36 14

SEE MAP 36 14 11B

SEE MAP 36 14

**RECEIVED**

DEC 29 1998

WATER RESOURCES DEPT.  
 SALEM, OREGON


**CURRY**

SEE MAP 36 14 11B

36 14 11BC

36 14 11BC