

FOR WATER RESOURCES DEPARTMENT USE ONLY

Date Postmarked 7-17-01

Date Hand-Delivered _____

Watermaster Initials _____

W 105657 46808

WRD Receipt _____

Date Fee Received 7-18-01Check No. 1625

RECEIVED

START CARD

JUL 18 2001

NOTICE OF BEGINNING OF WELL CONSTRUCTION

(as required by ORS 537.762)

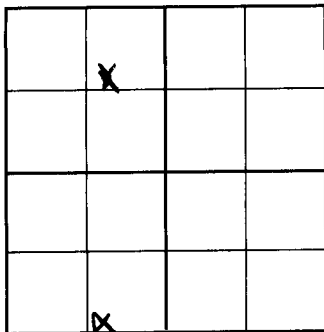
WATER RESOURCES DEPARTMENT
SALEM, OREGON

This form must be completed and the original copy mailed or delivered to the Water Resources Department, 158 12th St. NE, Salem, OR 97310, for all new well construction, or conversion of an existing hole not previously used to seek water. This original copy must be mailed or delivered no later than the day construction or conversion work begins. A \$75 fee shall accompany the original copy for all new well construction and conversion (make checks payable to the Water Resources Department). Notices meeting the submittal requirements but received without the required fee will not be accepted as properly and timely filed. In addition, the constructor shall provide the "Watermaster Copy" of this notice to the office of the district watermaster within which the well is being constructed, altered, converted or abandoned using one of the following options: (a) by regular mail no later than three (3) calendar days (72 hours) prior to commencement of work; or, (b) by hand delivery, during regular office hours, no later than the day work is commenced; or, (c) by FAX no later than the day work is commenced. If method (c) is used, the original "Watermaster Copy" of this notice shall also be mailed or delivered to the office of the district watermaster no later than the day work is commenced. The Water Resources Commission has authority to impose civil penalties for failure to submit the required \$75 fee with the start card and for failure to submit cards prior to beginning any construction, alteration, conversion or abandonment work.

Owner's name and mailing address: JAMES NOWAKHome Phone: 206 325 3654 555 12TH AVEWork Phone: 206 329 3914 SEATTLE, WA 98120Check type of work: Fee Required: ☒ New Construction No Fee Required: ☐ Alteration (Repair/Recondition)☐ Conversion ☐ Deepening Original Start Card Number _____Proposed Commencement Date: 7-17-01 ☐ AbandonmentExisting or Proposed Well Depth: 80' Diameter: 6" Original Well I.D. Label Number: _____Check Use: ☒ Domestic ☐ Public System (Community) ☐ Industrial ☐ Irrigation ☐ Monitoring☐ Thermal ☐ Injection ☐ Other _____Proposed Well Location: County CURRY Township: 32 Range: 19 Section: 10

North or South East or West

N

1. NE 1/4 of NW 1/4 of above section.

2. Street Address of well location (or directions if not assigned).

96630 SIXES RIVER ROAD
SIXES OR 974763. Tax-lot number of well location: 2301

4. Attach map with location identified. (See reverse for approved maps)

5. Show well location within 1/4, 1/4 of section grid at left.

We hereby certify that we have read the back of this form and that the information provided is accurate to the best of our knowledge.

Owner/Agent

Date Signed

Bonded Water/Monitor Well Constructor

Company

License No. 1604

Date Signed

OWNER PLEASE NOTE: This is not a water right application. The owner is responsible for obtaining a water right through the Water Resources Department, if required. The Oregon Health Division requires plans to be submitted and approved prior to construction if the well is to be used as a public system.

ADDITIONAL IMPORTANT INFORMATION ON BACK.

THIS COPY, WITH ACCOMPANYING FEE, TO WATER RESOURCES DEPARTMENT IN SALEM.