

OBSERVATION WELL

STATE ENGINEER
Salem, Oregon

Well Record

STATE WELL NO. 41/13W-90(2)
COUNTY Curry
APPLICATION NO. GR-4108

CURR 763

Now O. PENTER

OWNER: E. I. Rigdon

MAILING ADDRESS:

Box 310

LOCATION OF WELL: Owner's No.


CITY AND STATE:

Harbor, Oregon

SW 1/4 SE 1/4 Sec. 9 T. 41 S., R. 13 W., W.M.

Bearing and distance from section or subdivision

corner 40' SW DIC 40

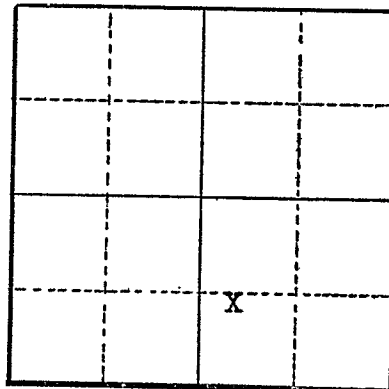

Section 9

Altitude at well

TYPE OF WELL: Drilled Date Constructed 6/54

Depth drilled 69 ft. Depth cased 69 ft.

CASING RECORD:

8 inch casing set to 69 feet

FINISH:

Perforated from 40 to 69 feet

AQUIFERS:

WATER LEVEL:

40 feet below surface

PUMPING EQUIPMENT: Type 3" turbine

H.P. 5

Capacity 90 G.P.M.

WELL TESTS:

Drawdown ft. after hours G.P.M.

Drawdown ft. after hours G.P.M.

USE OF WATER Irrigation

Temp. °F. 19

SOURCE OF INFORMATION Well Registration Statement Cert. # GR-3694

DRILLER or DIGGER Leo Schanahan

ADDITIONAL DATA:

Log Water Level Measurements Chemical Analysis Aquifer Test

REMARKS: