NOTICE TO WATER WELL CONTRACTOR
The original and first copy of this report
', are to be filed with the


WATER RESOURCES DEPARTMENT, SALEM, OREGON 97310 within 30 days from the date of well completion.

WATER WELL REPORT

STATE OF OREGON

(Please type or print)

(Do not write above this line)

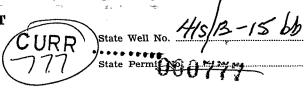

(1) OWNER:	(10) LOCATION OF WELL:	
Name Norm Yock	County Curry Driller's well number	
Address Route 1 Box 52 E	NW 14 NW 14 Section 15 T. 41s I	R. 13w w.м.
Brookings, Ore	Bearing and distance from section or subdivision	ı corner
(2) TYPE OF WORK (check):	Well # 13	
New Well Deepening Reconditioning Abandon		
If abandonment, describe material and procedure in Item 12.	(11) WATER LEVEL: Completed we	11.
(3) TYPE OF WELL: (4) PROPOSED USE (check):	Depth at which water was first found	22 1 ft.
Rotary Driven Domestic Industrial Municipal	Static level $22\frac{1}{2}$ ft. below land su	rface. Date 3-25-80
Bored □ Irrigation X Test Well □ Other □	Artesian pressure lbs. per square	
(5) CASING INSTALLED: 8 " Diam. from + 2 ft. to 42 ft. Gage •250 6 " Diam. from from ft. to 49!-8" ft. Gage •250 " Diam. from ft. to ft. Gage •250 (6) PERFORATIONS: Perforated? Yes No.	(12) WELL LOG: Diameter of well below casing	
Type of perforator used	MATERIAL	From To SWL
Size of perforations in. by in.	All measurements taken at cas	ing line which
perforations from ft. to ft.	is two feet above ground line.	2 6
perforations from ft. to ft.	Clay soil black	2 6 6 11
perforations from ft. to ft.	Clay brown	11 21
(7) SCREENS: Well screen installed? ✓ Yes □ No	Clay with gravel brown Gravel with sand and	21 21
Manufacturer's Name Johnson	boulders brown	46 1
Type Stainless steel Model No. telescope	Claystone blue	464 50
Diam. 8 Slot size 020. Set from 41 ft. to 46! 8!! ft.	··io	
Diam. Slot size Set from ft. to ft.		
(8) WELL TESTS: Drawdown is amount water level is lowered below static level	RECEIVED	
a pump test made? Yes No If yes, by whom? Yield: gal./min. with ft. drawdown after hrs.	APR 1 1980	
n n	WATER RESOURCES DEPT	
,, n, n	SALEM, OREGON	
wer test 20 gal./min. with 16 ft. drawdown after 1 hrs.		
Artesian flow g.p.m.		
Temperature of water 52 Depth artesian flow encountered ft.	Work started 3-19- 19 80 Completes	d 3– 25 19 80
(9) CONSTRUCTION:	Date well drilling machine moved off of well	3-26 ¹⁹ 80
Well seal—Material used Cement Well sealed from land surface to 20 ft. Diameter of well bore to bottom of seal 12 in. Diameter of well bore below seal 8 in. Number of sacks of cement used in well seal 15 sacks How was cement grout placed? Pumped via tremie pipe	Drilling Machine Operator's Certification: This well was constructed under my Materials used and information reported best knowledge and belief Control (Drilling Machine Operator) Drilling Machine Operator's License No Water Well Contractor's Certification:	Date 3-30 , 19 80
	This well was drilled under my jurisdiction:	rtion and this report is
Was a drive shoe used? ☐ Yes 🔏 No Plugs Size: location ft.	true to the best of my knowledge and beling the Bill Miller Well Drilling	ef.
Did any strata contain unusable water? Yes No	(Person, firm or corporation)	(Type or print)
Type of water? depth of strata Method of sealing strata off	Address Rouge 1, Box 1115 Band	on, Ore, 97411
Method of sealing strata off	[Signed] (Water Well Contra	full (
Was well gravel packed? Yes No Size of gravel:	Contractor's License No. 600 Date	3-30 19.80