
NOTICE TO WATER WELL CONTRACTOR
The original and first copy of this report
are to be filed with the

WATER RESOURCES DEPARTMENT, SALEM, OREGON 97310 within 30 days from the date of well completion.

## WATER WELL REPORT

(Please type or print)

(Do not write above this line)

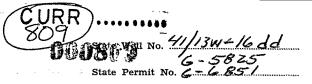

(1) OWNER:	(10) LOCATION OF WELL:	
Name GARY STRAHM	County CURRY Driller's well n	umber OWNER
Address 15441 Ocean view Prive	5E 1/4 5E 1/4 Section 16 T. 415	
BROOKINGS, Oregon 97415	Bearing and distance from section or subdivisi	
(2) TYPE OF WORK (check):	Within 15' of Hel	
New Well ☑ Deepening ☐ Reconditioning ☐ Abandon ☐	Clesus ONE A	
If abandonment, describe material and procedure in Item 12.	(11) WATER LEVEL: Completed w	
(3) TYPE OF WELL: (4) PROPOSED USE (check):	The state of the s	
Rotary Driven Domestic Industrial Municipal		surface. Date 3-1-80
D Jetted   Irrigation Test Well   Other		re inch. Date
(5) CASING INSTALLED: Threaded Welded Welded W. Diam. from ft. to 29 ft. Gage 44	(12) WELL LOG: Diameter of well below casing	
"Diam. fromft. toft. Gage	Formation: Describe color, texture, grain size and show thickness and nature of each stratu with at least one entry for each change of forma	im and aquifer penetrated, ition. Report each change in
(6) PERFORATIONS: Perforated? Yes No.  Type of perforator used Torch	position of Static Water Level and indicate prin	rcipal water-bearing strata.  From To SWL
	Black LOAM	1
Size of perforations 14 in. by 0 in.  perforations from 18 ft. to 28 ft.	Brown CLAY	2 20
perforations fromft. toft.	RIVER GRAVEL	20 39 11
perforations fromft. toft.	R	
(E) CODYTTM		
(7) SCREENS: Well screen installed?  Yes No Manufacturer's Name		
Type Model No.		
Diam Slot size Set from ft. to ft.		
Diam Slot size Set from ft. to ft.	RECEIVED	
(8) WELL TESTS: Drawdown is amount water level is	NLULIVLU	
lowered below static level	AUG 2 9 1980	
a pump test made? Yes XNo If yes, by whom?		
d: gal./min. with ft. drawdown after hrs.	WATER RESOURCES DEPT	
n " " "	SALEM, OREGON	
" " " "	*	
Bailer test gal./min. with ft. drawdown after hrs.		
essian flow g.p.m.		
Temperature of water Depth artesian flow encountered ft.	Work started 10 - 1 19 79 Complet	ed 5-/- 1980
(9) CONSTRUCTION: native	Date well drilling machine moved off of well	3-1 19 80
Well seal-Material used 20% bentonite 80% clay	Drilling Machine Operator's Certification:	}
Well sealed from land surface toft.	This well was constructed under my	direct supervision.
Diameter of well bore to bottom of seal 4/X8 in-	Materials used and information reported best knowledge and belief.	above are true to my
Diameter of well bore below seal	[Signed]	
Number of sacks of cement used in well seal		
How was cement grout placed? See ATACHED	Drilling Machine Operator's License No.	
Completed As noted on Special	Water Well Contractor's Certification:	
5.TANDARDS	This well was drilled under my jurisdiction and this report is	
Was a drive shoe used? 🗌 Yes 🐧 No Plugs Size: location ft.	true to the best of my knowledge and belief.	
Did any strata contain unusable water?   Yes No	Name Gary STranw (Pelson, firm or corporation)	(Type or print)
Type of water? GOOD depth of strata 10 ff.	Address 15441 Oceanview	~ . ~ .
Method of sealing strata off		·
Was well gravel packed? Yes I No Size of gravel: 12 minus	[Signed] (Water Well Control	ractor)
Gravel placed from	•	-18 i&
16. (0	Contractor's License No Date &	, 19 <b>0.</b>

16+ 15 FF

FROM WATER RESOURCES DEPARTMENT

DAM SAFETY & WELLS DIVISION

DAM SAFETY & WELLS DIVISION
556-13th Street N. E.
SALEM, OREGON 97310
PHONE (503) 378-8456

O: Room 104, Justice Building

Roseburg, Oregon 97470

M. John Youngquist, Watermaste

Special Standards for Water Well Construction

DATE: 6-25-79

Gary Strahm

Phone: 469-4065 Rt. 1, Box 39 RA

Brookings, Oregon 97415

AUG 29 1980
WATER RESOURCES DEPT
SALEM. OREGON

SIGNED

wasting the only standard not not by applicant's method of construction is material wasting the two cal (CAR 61-1)6 & 61-216); the standards shall be modified for this well as follows:

1) All standards shall be not during construction excluding OAR 61-196 & 61-206.

- 2) Sealing of this well shall be as follows:
  - A) A minimum of 3" reinforced concrete shall be placed at -19.
  - B) -13 to -2 a mixture of 20% bentonite and 80% native clay shall placed; -2 to land surface: native clay shall be placed.

DATE 6-28-79 SIGNED 11/1-1-

