

STATE ENGINEER
Salem, Oregon

Well Record

STATE WELL NO. 31/15W-32E
COUNTY Curry
APPLICATION NO. GR-3377

CURR · 000986

OWNER: Calvin J. Blair


MAILING ADDRESS: P.O. Box 302

LOCATION OF WELL: Owner's No.

CITY AND STATE: Sixes, Oregon

SW 1/4 NW 1/4 Sec. 32 T. 31 N S, R. 15 W, W.M.

Bearing and distance from section or subdivision corner 1200' E. and 150' N.

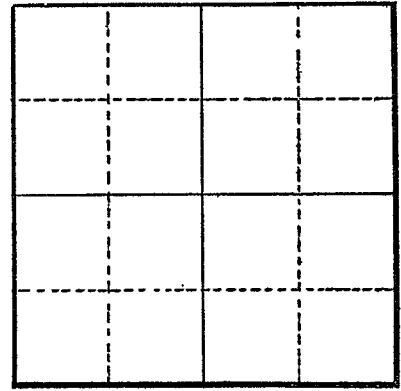

Section

Altitude at well

TYPE OF WELL: Dragline ^{sump} Date Constructed 1949

Depth drilled 12' Depth cased

CASING RECORD:

FINISH:

AQUIFERS:

soil, sand, gravel

WATER LEVEL:

9'

PUMPING EQUIPMENT: Type 5" Centrifugal H.P.
Capacity 100 G.P.M.

WELL TESTS:

Drawdown 1 ft. after hours pumping 100 G.P.M.
Drawdown ft. after hours G.P.M.

USE OF WATER Irrigation GR-3121 Temp. °F., 19

SOURCE OF INFORMATION
DRILLER or DIGGER owner

ADDITIONAL DATA:

Log Water Level Measurements Chemical Analysis Aquifer Test

REMARKS:

Peat Soil 1' 1'
Hard Pan (sand) 7' 8'
Gray Sand 2' 11'
Gray Sand & Gravel 1' 12'