
NOTICE TO WATER WELL CONTRACTOR The original and first copy of this report are to be filed with the


WATER RESOURCES DEPARTMENT SALEM, OREGON 97310 STATE OF OREGON (Please type or print) within 30 days from the date

FEB 1197(po not write above this line)

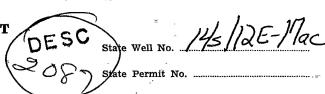

of well completion. FEB 1197 to not write ab	ove this line)			
WATER RESOURCES DEPT.	(10) LOCATION OF WELL:			
(1) OWNER: SALEM, OREGON				
Name Bobby Beesley Address Culver, Ore. 97734	•			
Address Culver, Ore. 97739		R. 12E		W.M.
(2) TYPE OF WORK (check):	Bearing and distance from section or subdivisi			
New Well Deepening □ Reconditioning □ Abandon □	800 ft. north and 1,540 ft. we east quarter corner of Section		rom_ti	1 e
If abandonment, describe material and procedure in Item 12.		•		
	(11) WATER LEVEL: Completed w	ell.		
(3) TYPE OF WELL: (4) PROPOSED USE (check):	Depth at which water was first found			ft.
Rotary [7]. Driven Domestic Industrial Municipal Domestic Industrial Municipal I	Static level 171 ft. below land s	urface.	Date 1-	<u>-3-79</u>
Dug	Artesian pressure lbs. per squar	e inch.	Date	
CASING INSTALLED: Threaded Welded 16 gage 250 ft. to 19 ft. Gage 250	(12) WELL LOG: Diameter of well h	elow cas		
· · · · · · · · · · · · · · · · · · ·	Depth drilled 262 ft. Depth of compl	eted well	262	et.
" Diam. from	Formation: Describe color, texture, grain size			
Diant, from the Gage	and show thickness and nature of each stratu with at least one entry for each change of forma			
PERFORATIONS: Perforated? Yes XNo.	position of Static Water Level and indicate prin	-		-
Type of perforator used	MATERIAL	From	То	SWL
Size of perforations in. by in.	brown soil & small boulders	0	5	
perforations from ft. to ft.	brown coarse sandstone	5	76	
perforations from ft. to ft.	brown coarse sandstone &			
perforations from ft. to ft.	large boulders	76	191	171
(7) SCREENS: Well screen installed? Yes No	black fine sand & gravel WB	191	223	
Manufacturer's Name	black doarse sand & gravel W.B.	223	252	
Type Model No.	red soft rock	252	262	_
Diam, Slot size Set from ft. to ft.	Tot Bot o Tock	اعريا	202	
Diam Slot size Set from ft. to ft.				
(8) WELL TESTS: Drawdown is amount water level is lowered below static level				
Was a pump test made? ☐ Yes ☐XNo If yes, by whom?				
Yield: gal./min. with ft. drawdown after hrs.	_			
" " "				
n n n				<u> </u>
Bailer test 8 gal./min. with no ft. drawdown after 1 hrs.		 		
Artesian flow g.p.m.	-	<u> </u>		
perature of water Depth artesian flow encountered ft.	Work started 12-26 1978 Complete	$\frac{1}{2}$	-4	19 79
(9) CONSTRUCTION:	Date well drilling machine moved off of well		- 5	¹⁹ 79
a amount	Drilling Machine Operator's Certification:			
Well sealed from land surface to -19 ft.	This well was constructed under my Materials used and information reported	direct		
Diameter of well bore to bottom of sealin.	best knowledge and belief.		are mu	, to my
Diameter of well bore below sealin.	[Signed] Jany K. Granf	Date	1-8	., 1979
Number of sacks of cement used in well seal 2 sacks	Drilling Machine Operator's License No.	678		
How was cement grout placed? gravity flow	Drining Machine Operator's License No.			
	Water Well Contractor's Certification:			
	This well was drilled under my jurisd true to the best of my knowledge and bel		nd this 1	eport is
Was a drive shoe used? \square Yes \square No Plugs Size: location ft.	1			
Did any strata contain unusable water? 🗌 Yes 🕻 No	Name Crawfort Well Drilling, (Person, firm or corporation)			
Type of water? depth of strata	Address 1245 N.W. Lower Bridge	Terre	bonne	,-Ore.
Method of sealing strata off	[Signed] Lanny S. Grant	fond		
Was well gravel packed? ☐ Yes X No Size of gravel:	(Water Well Confi	-	<u></u>	*************
Gravel placed from ft. to ft.	Contractor's License No570 Date	1	- 8	, 19.79

DESC 2087

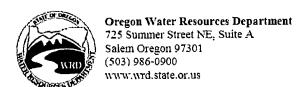

Last Update: 8/1/16

Application for

Well ID Number

RECEIVED

Do not complete if the well already has a Well Identification Number.

DEC 1 1 2017

		WATER RESOURCES DEPT
I. OWNER INFORMATION	7 F TO TO THE	UNLEW, UREGON
Current Owner Name (please print):	TIG FALLS RANCH CO., (REX BAN	EBER.)
Mailing Address:		
City, State, Zip:	ERREBONNE, OR 97760	
Mail Well ID Tag to: SAME A	S ABOVE In Care Of (C/O)	
Name & Address:		
City. State. Zip:		
	ION (Please fill out as completely as possible)	
Township: 14 (North / Will)	Range: 12 East West) Section: 17	
444 . 4	x Map #): 140Z County <u>T</u>	
GPS Coordinates: 44.3.5900, -1	121,31786	
Street Address of Well. City: 70470	121,31786 NW LOWER BRIDGE WAY, TERRES	onne, or
	ress in the past:	•
III. GENERAL WELL INFORMATION Use of Well (domestic, irrigation, common Date Well Constructed (or property built Owner at time the well was constructed Other Information: PA#2, Wissenstructed SUBMITTED BY (please print): Wissenstructed PHONE: 541/639-4109 Send application to: Oregon Water Resour	ON (Please fill out as completely as possible, AND a nercial, industrial, monitoring): TRIGATION (if known): Bob Bressery Well Legel #3; Also, there is a cleaned with the complete with the co	Casing Diameter: 16" og # (if known): Desc 2087 out log - Desc 2086 CNEPECTOR - SCR