

STATE OF OREGON  
**WATER SUPPLY WELL REPORT**  
 (as required by ORS 537.765)

WELL I.D. # L 62042  
 START CARD # 154242

Instructions for completing this report are on the last page of this form.

(1) **LAND OWNER** Well Number \_\_\_\_\_  
 Name WAYNE MICHELLE Judd  
 Address 50186 COLLAR DR.  
 City LAPINE State ORE Zip 97739

(2) **TYPE OF WORK**  
 New Well  Deepening  Alteration (repair/recondition)  Abandonment

(3) **DRILL METHOD:**  
 Rotary Air  Rotary Mud  Cable  Auger  
 Other \_\_\_\_\_

(4) **PROPOSED USE:**  
 Domestic  Community  Industrial  Irrigation  
 Thermal  Injection  Livestock  Other \_\_\_\_\_

(5) **BORE HOLE CONSTRUCTION:**  
 Special Construction approval  Yes  No Depth of Completed Well 26 ft.  
 Explosives used  Yes  No Type \_\_\_\_\_ Amount \_\_\_\_\_

HOLE			SEAL			
Diameter	From	To	Material	From	To	Sacks or pounds
16"	0	18	3" material	0	18	24
6"	18	26	7"			

How was seal placed: Method  A  B  C  D  E  
 Other POURED  
 Backfill placed from \_\_\_\_\_ ft. to \_\_\_\_\_ ft. Material \_\_\_\_\_  
 Gravel placed from \_\_\_\_\_ ft. to \_\_\_\_\_ ft. Size of gravel \_\_\_\_\_

(6) **CASING/LINER:**

Diameter	From	To	Gauge	Steel	Plastic	Welded	Threaded
Casing: 6"	0	18	18 1/2	.250 X	<input type="checkbox"/>	<input type="checkbox"/>	<input type="checkbox"/>
Liner: 4 1/2" PVC	6'	26'	SDR26		<input checked="" type="checkbox"/>	<input type="checkbox"/>	<input type="checkbox"/>

Drive Shoe used  Inside  Outside  None  
 Final location of shoe(s) NONE

(7) **PERFORATIONS/SCREENS:**  
 Perforations Method SAWED  
 Screens Type \_\_\_\_\_ Material \_\_\_\_\_

From	To	Slot size	Number	Diameter	Tele/pipe size	Casing	Liner
16'	26'	6" x 6"	65	4 1/2" PVC	SDR26	<input type="checkbox"/>	<input checked="" type="checkbox"/>

(8) **WELL TESTS: Minimum testing time is 1 hour**

Yield gal/min	Drawdown	Drill stem at	Flowing Time
27	1 1/2'		2 1/2 hr.

Flowing  Pump  Bailer  Air  Artesian

Temperature of water 43°F Depth Artesian Flow Found \_\_\_\_\_  
 Was a water analysis done?  Yes  No By whom NONE  
 Did any strata contain water not suitable for intended use?  Too little  
 Salty  Muddy  Odor  Colored  Other \_\_\_\_\_  
 Depth of strata: 7'

(9) **LOCATION OF WELL by legal description:**  
 County DESCHUTES Latitude \_\_\_\_\_ Longitude \_\_\_\_\_  
 Township 22 N or S Range 9 E or W. WM.  
 Section 35D NE 1/4 SE 1/4  
 Tax Lot 100 Lot \_\_\_\_\_ Block \_\_\_\_\_ Subdivision \_\_\_\_\_  
 Street Address of Well (or nearest address) SAME AS OWNERS


(10) **STATIC WATER LEVEL:**  
17' ft. below land surface. Date 7-29-03  
 Artesian pressure \_\_\_\_\_ lb. per square inch Date \_\_\_\_\_

(11) **WATER BEARING ZONES:**  
 Depth at which water was first found 19'

From	To	Estimated Flow Rate	SWL
19'	26'	279 gpm	17'

(12) **WELL LOG:**  
 Ground Elevation \_\_\_\_\_

Material	From	To	SWL
Pumny	0	5	
Clay, Brown	5	19	
Pumny	19	26	17

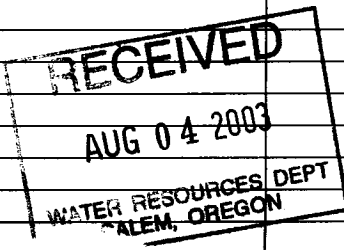

Date started 7-29-03 Completed 7-29-03

(unbonded) **Water Well Constructor Certification:**  
 I certify that the work I performed on the construction, alteration, or abandonment of this well is in compliance with Oregon water supply well construction standards. Materials used and information reported above are true to the best of my knowledge and belief.  
 WWC Number \_\_\_\_\_  
 Signed \_\_\_\_\_ Date \_\_\_\_\_

(bonded) **Water Well Constructor Certification:**  
 I accept responsibility for the construction, alteration, or abandonment work performed on this well during the construction dates reported above. All work performed during this time is in compliance with Oregon water supply well construction standards. This report is true to the best of my knowledge and belief.  
 WWC Number 639  
 Signed Gerald V. Brown Date 7-29-03