

WELL LABEL # L 79419

START CARD # 181703

(1) LAND OWNER Owner Well I.D. _____
 First Name _____ Last Name _____
 Company JACK ROBINSON AND SONS
 Address PO BOX 5006
 City BEND State OR Zip 97708

(2) TYPE OF WORK New Well Deepening Conversion
 Alteration (repair/recondition) Abandonment

(3) DRILL METHOD
 Rotary Air Rotary Mud Cable Auger Cable Mud
 Reverse Rotary Other _____

(4) PROPOSED USE Domestic Irrigation Community
 Industrial/ Commercial Livestock Dewatering
 Thermal Injection Other _____

(5) BORE HOLE CONSTRUCTION Special Standard (Attach copy)
 Depth of Completed Well 332.00 ft.

BORE HOLE			SEAL				sacks/
Dia	From	To	Material	From	To	Amt	lbs
12	0	330	Bentonite Chips	0	8	25	S
8	330	332	Cement	8	175	113	S

How was seal placed: Method A B C D E
 Other Poured dry

Backfill placed from _____ ft. to _____ ft. Material _____

Filter pack from _____ ft. to _____ ft. Material _____ Size _____

Explosives used: Yes Type _____ Amount _____

(6) CASING/LINER

Casing	Liner	Dia	+	From	To	Gauge	Stl	Plstc	Wld	Thrd
<input checked="" type="checkbox"/>	<input type="checkbox"/>	8	<input checked="" type="checkbox"/>	2	330	.250	<input checked="" type="checkbox"/>	<input type="checkbox"/>	<input checked="" type="checkbox"/>	<input type="checkbox"/>

Shoe Inside Outside Other Location of shoe(s) _____

Temp casing Yes Dia _____ From _____ To _____

(7) PERFORATIONS/SCREENS

Perforations Method Machine
 Screens Type _____ Material _____

Perf/	Casing/	Screen	Scrn/slot	Slot	# of	Tele/		
Screen	Liner	Dia	From	To	width	length	slots	pipe size
Perf	Casing	8	270	330	.125	3	912	

(8) WELL TESTS: Minimum testing time is 1 hour

Pump Bailer Air Flowing Artesian

Yield gal/min	Drawdown	Drill stem/Pump depth	Duration (hr)
300		330	2

Temperature 53 °F Lab analysis Yes By _____

Water quality concerns? Yes (describe below)

From	To	Description	Amount	Units

(9) LOCATION OF WELL (legal description)

County Deschutes Twp 14.00 S N/S Range 13.00 E E/W WM
 Sec 33 NW 1/4 of the SW 1/4 Tax Lot 1200
 Tax Map Number _____ Lot _____
 Lat 44 ° 18 ' 41.000 " or 44.31138889 DMS or DD
 Long -121 ° 11 ' 3.000 " or -121.18416667 DMS or DD
 Street address of well Nearest address

PERSHALL WAY

(10) STATIC WATER LEVEL

	Date	SWL(psi)	+	SWL(ft)
Existing Well / Predeepening				
Completed Well	<u>04-24-2006</u>			<u>197</u>

Flowing Artesian?

WATER BEARING ZONES

Depth water was first found 210

SWL Date	From	To	Est Flow	SWL(psi)	+	SWL(ft)
04-19-2006	210	220	100			197
04-19-2006	230	330	300			197

(11) WELL LOG

Ground Elevation 2,926

Material	From	To
Sandstone Brown	0	30
Cinders Red	30	45
Sandstone Gray	45	75
Conglomerate Broken Lava	75	110
Sandstone Pumice Layers	110	150
Basalt Clay Seams Purple	150	185
Lava Creviced	185	205
Basalt Cinders Broken	205	220
Basalt Fractured	220	265
Cinders Conglomerate	265	275
Sandstone Brown	275	332

Date Started 04-17-2006 Completed 04-24-2006

(unbonded) Water Well Constructor Certification

I certify that the work I performed on the construction, deepening, alteration, or abandonment of this well is in compliance with Oregon water supply well construction standards. Materials used and information reported above are true to the best of my knowledge and belief.

License Number 758 Date 04-24-2006
 Electronically Filed
 Signed THOMAS R PECK (E-filed)

(bonded) Water Well Constructor Certification

I accept responsibility for the construction, deepening, alteration, or abandonment work performed on this well during the construction dates reported above. All work performed during this time is in compliance with Oregon water supply well construction standards. This report is true to the best of my knowledge and belief.

License Number 1720 Date 04-24-2006
 Electronically Filed
 Signed JACK ABBAS (E-filed)
 Contact Info (optional)

(5) BORE HOLE CONSTRUCTION

BORE HOLE			Material	SEAL		Amt	sacks/ lbs
Dia	From	To		From	To		

FILTER PACK

From	To	Material	Size

(6) CASING/LINER

Casing	Liner	Dia	+	From	To	Gauge	Stl	Plstc	Wld	Thrd

(7) PERFORATIONS/SCREENS

Perf/ Screen	Casing/ Liner	Screen Dia	From	To	Scrn/slot width	Slot length	# of slots	Tele/ pipe size

(8) WELL TESTS: Minimum testing time is 1 hour

Yield gal/min	Drawdown	Drill stem/Pump depth	Duration (hr)

Water Quality Concerns

From	To	Description	Amount	Units

(10) STATIC WATER LEVEL

Water Bearing Zones

SWL Date	From	To	Est Flow	SWL(psi)	+	SWL(ft)


(11) WELL LOG

Material	From	To

Comments/Remarks

5 yrds sand grout 36 feet to 140 feet shale trap at 175 feet

Map of well

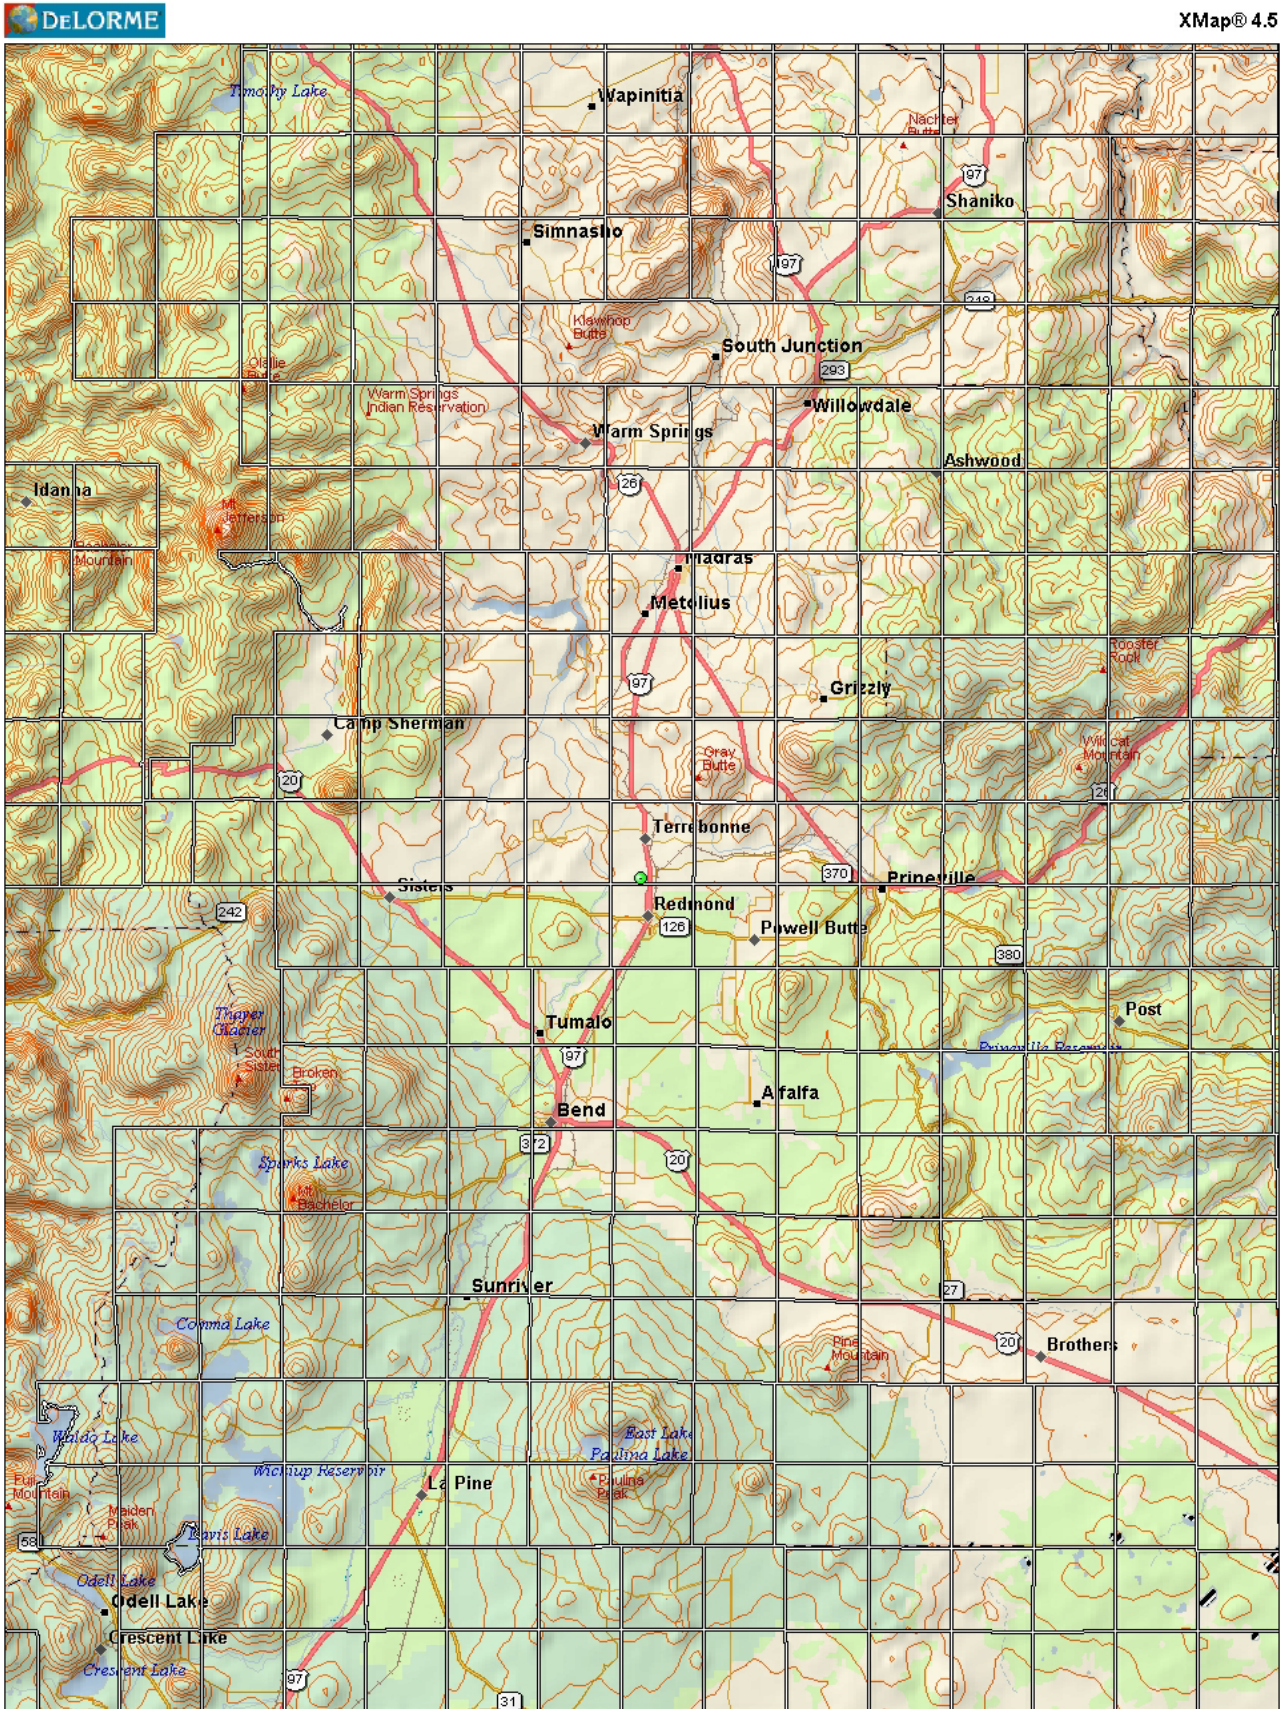

Data use subject to license.
© 2004 DeLorme. XMap® 4.5.
www.delorme.com

