

**CITY OF REDMOND
WELL #7 DRILLERS FROMATION LOG**

Description		From	To	
3/4" Crushed Rock		0	1	
Broken Gray Lava		1	15	
Gray Basalt		15	31	
Red Cinders		31	34	
Broken Black/Red Rock		34	53	
Brown Rock		53	61	
Black Lava		61	77	
Brown Sandstone		77	84	
Brown Conglomerate		84	88	
Black Lava		88	107	
Brown Sandstone		107	121	
Redish & Black Lava		121	130	
Brown Sandstone		130	133	
Black Lava		133	144	
Gray Lava		144	158	
Reddish Brown Rock		158	159	
Brown Rock		159	172	
Brown Sandstone		172	176	
Red and Black Lava		176	181	
Redish & Brown Sandstone		181	191	
Black Lava		191	206	
Brown Sandstone		206	209	
Coarse Black Sand		209	221	
Black Lava		221	243	
Brown Sandstone		243	249	
Black Lava & with Brown Ash		249	273	
Hard Black Basalt		273	283	
Red Sandstone		283	306	
Brown Sandstone		306	325	
Light Brown Sandstone		325	335	
Dark Brown Sandstone	WB	335	391	330
Black Sandstone	WB	391	423	328
Fine Black Sand	WB	423	458	328
Brown Sandstone	WB	458	526	328
Broken Blue & Gray Basalt	WB	526	529	328
Blue & Gray Basalt	WB	529	537	328
Gray Basalt	WB	537	553	328
No Cuttings Semi Soft	WB	553	565	328
No Cuttings Harder	WB	565	580	328
Red & Black Basalt	WB	580	600	328
No Cuttings Broken & Hard	WB	600	610	328
Black Basalt	WB	610	613	328
Black Sandstone	WB	613	625	328
Brown Sandstone	WB	625	632	328
Reddish Brown Sandstone	WB	632	641	328
Multi Colored Coarse Sand	WB	641	658	328

RECEIVED

FEB 07 2007

WATER RESOURCES DEPT
SALEM, OREGON**RECEIVED**

JAN 17 2007

WATER RESOURCES DEPT
SALEM, OREGON

DESC 57788

Dark Brown Sandstone	WB	658	690	328
Brown Sandstone	WB	690	706	328
Blue & Gray Basalt	WB	706	711	328
Gray Basalt	WB	711	731	328
No Cuttings Soft	WB	731	734	328
No Cuttings Harder	WB	734	741	328
No Cuttings Soft	WB	741	745	328
No Cuttings Harder	WB	745	750	328
Broken Vesicular Basalt	WB	750	754	327
Black Sandstone	WB	754	770	327
Black & Brown Sandstone	WB	770	785	327
Vesicular Black Basalt	WB	785	790	327
Vesicular Red & Black Basalt	WB	790	800	327
Hard & Broken No Cuttings	WB	800	810	327
Brown Sandstone with Multi				327
Colored Sand Lenses	WB	810	818	327
Vesicular Red & Black Basalt	WB	818	826	327
Black Sandstone	WB	826	831	327
Black & Gray Basalt	WB	831	838	327
Red & Black Basalt	WB	838	843	327
Vesicular Black Basalt	WB	843	847	327
Hard Black & Gray Basalt	WB	847	850	327
Very Hard Gray Basalt		850	960	327

RECEIVED

FEB 07 2007


WATER RESOURCES DEPT
SALEM, OREGON

RECEIVED

JAN 17 2007

WATER RESOURCES DEPT
SALEM, OREGON

CITY OF REDMOND WELL #7 AS BUILT

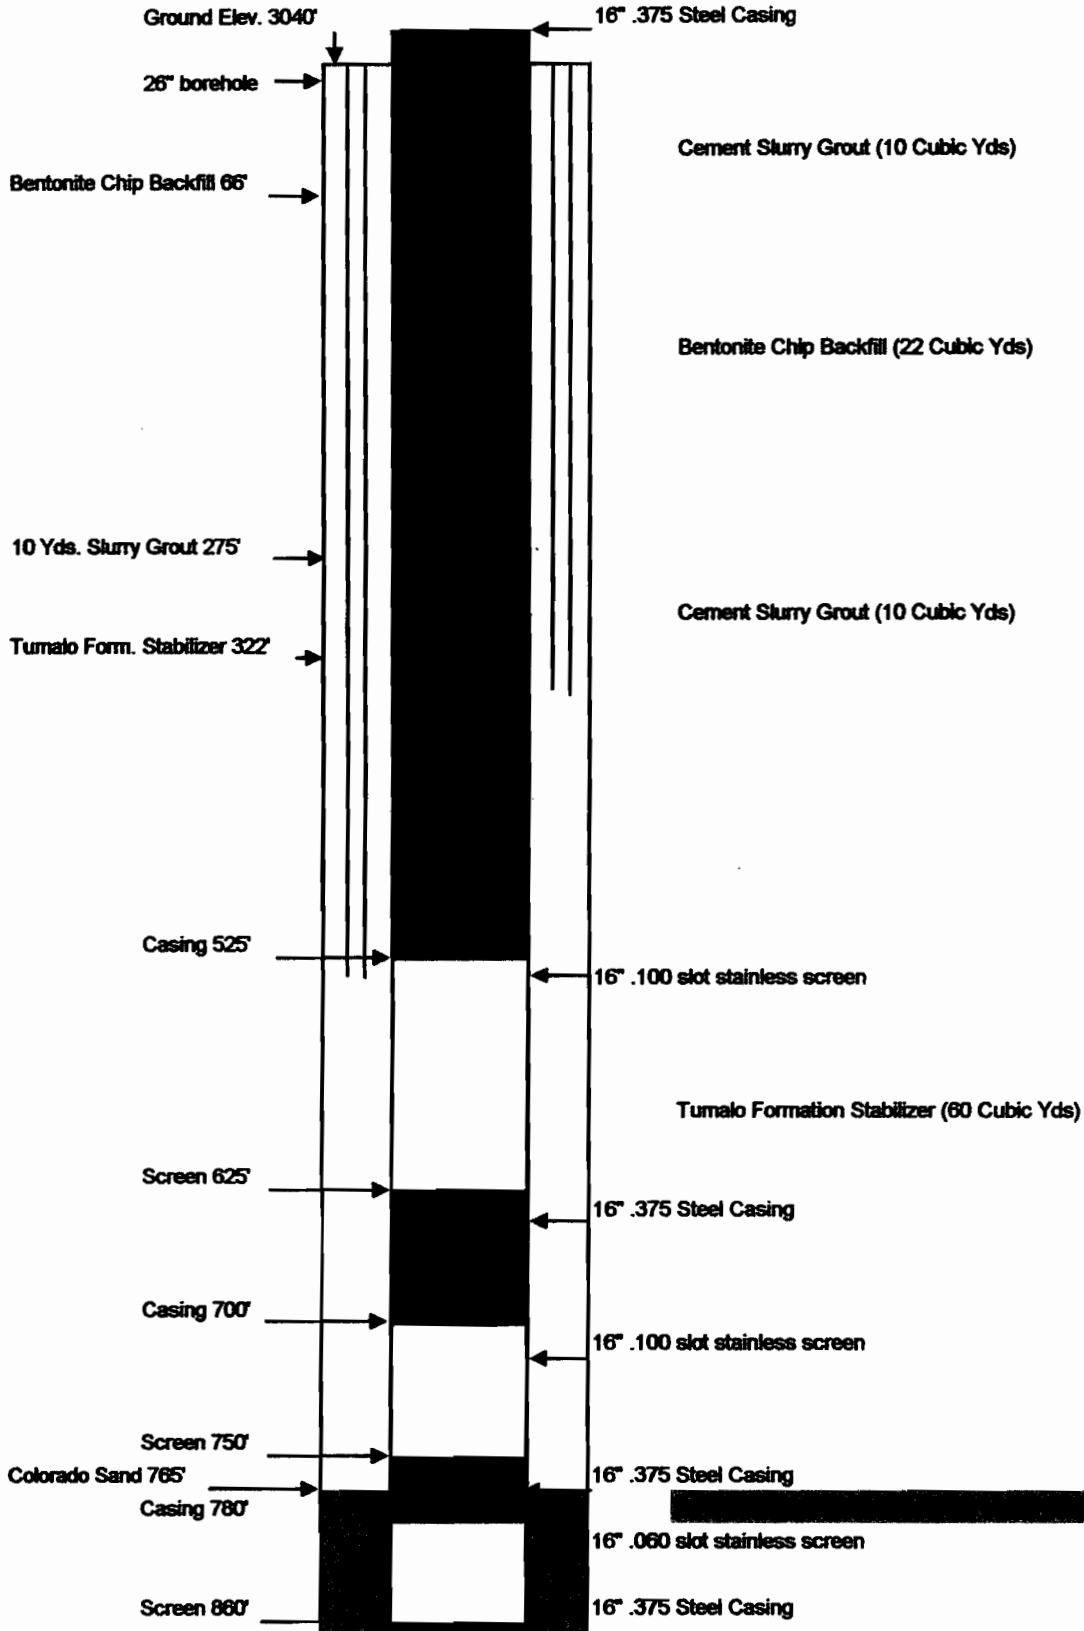

RECEIVED

FEB 07 2007

WATER RESOURCES DEPT
SALEM, OREGON

RECEIVED

JAN 17 2007

WATER RESOURCES DEPT
SALEM, OREGON