
STATE OF OREGON	DESC 60151 WELL I.D. LABEL# L ₁₁₆₅₇₀
WATER SUPPLY WELL REPORT	START CARD # 1024744
(as required by ORS 537.765 & OAR 690-205-0210)	11/19/2014 ORIGINAL LOG #
) LAND OWNER Owner Well I.D.	
irst Name BRENT Last Name GOODMAN	(0) I OCATION OF WELL (legal description)
l'ompany	(9) LOCATION OF WELL (legal description)
ddress 64711 OTTER RUN LN	County DESCHUTES Twp 16.00 S N/S Range 11.00 E E/V
ity BEND State OR Zip 97701	Sec 23 SE 1/4 of the SE 1/4 Tax Lot 521
TYPE OF WORK New Well Deepening	Tax Map Number Lot
Alteration (complete 2a & 10) Abandonn	Conversion Lat or DMS o
a) PRE-ALTERATION	Long Of DMS o
Dia + From To Gauge Stl Plstc Wld	Thrd O Street address of well O Nearest address
	65320 HWY 20
Material From To Amt sacks/lbs	
Seal:	
) DRILL METHOD	(10) STATIC WATER LEVEL Date SWL(psi) + SWL(ft
Rotary Air Rotary Mud Cable Auger Cable	E Mud Date SWL(psi) + SWL(ft Existing Well / Pre-Alteration
Reverse Rotary Other	Completed Well 11/6/2014 641
PROPOSED USE Domestic Irrigation Com	
	WATER BEARING ZONES Depth water was first found <u>645.00</u>
Thermal Injection Other	SWL Date From To Est Flow SWL(psi) + SWL(i
BORE HOLE CONSTRUCTION Special Standard	d (Attach copy) 11/6/2014 645 770 20 641
Depth of Completed Well 770.00 ft.	
BORE HOLE SEAL	sacks/
	To Amt lbs
12 0 243 Bentonite Chips 0 8	
8 243 770 Cement 8 243	3 132 S
	(11) WELL LOG Ground Elevation
	Glound Elevation
	D E Material From To
X Other POURED DRY	TOP SOIL 0 2
Backfill placed from ft. to ft. Material	BROWN SANDSTONE 2 8 Size MILD GRAY LAVA 8 41
Filter pack from ft. to ft. Material	Size MILD GRAT LAVA 8 41
	41 65
Explosives used: Yes Type Amount	COARSE BROWN CONCLOMERATE 41 05
Explosives used: Yes Type Amount	BROWN SANDSTONE 65 162





















ORIGINAL - WATER RESOURCES DEPARTMENT THIS REPORT MUST BE SUBMITTED TO THE WATER RESOURCES DEPARTMENT WITHIN 30 DAYS OF COMPLETION OF WORK Form Version:

WATER SUPPLY WELL REPORT -

continuation page

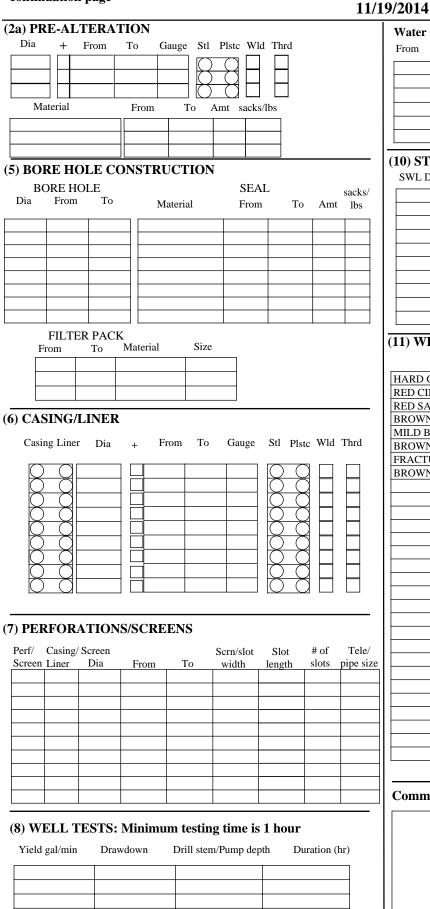

DESC 60151

WELL I.D. LABEL# L START CARD # 1024744 ORIGINAL LOG

Page 2 of 2

Water Quality Concerns

From	То	Description	Amount	Units

(10) STATIC WATER LEVEL

SWL Date	From	То	Est Flow	SWL(psi)	+ SWL(ft)

(11) WELL LOG

Material	From	То
HARD GRAY LAVA	434	461
RED CINDERS CONGLOMERATE	461	472
RED SANDSTONE	472	493
BROWN SANDSTONE	493	546
MILD BROWN LAVA	546	555
BROWN SANDSTONE COARSE	555	645
FRACTURED BROWN LAVA W/B	645	751
BROWN SANDSTONE W/B	751	770
		-

Comments/Remarks