
					Page 1 of 2
STATE OF OREGON	DESC	60493	WELL I.D. LABEL# L	121557	
WATER SUPPLY WELL REPORT	2200	001/0	START CARD #	1028947	
(as required by ORS 537.765 & OAR 690-205-0210)	2/9/2	2016	ORIGINAL LOG #		
(1) LAND OWNER Owner Well I.D.	_/ > / _			<u> </u>	
First Name JOCELYN Last Name ANDERSON	•			•	
			ION OF WELL (legal de		
CompanyAddress 62905 JOHNSON RANCH RD			<u>TTES</u> Twp <u>17.00</u> S N/S		
		Sec 22 N	NE $1/4$ of the SE	1/4 Tax Lot 80	2
City BEND State OR Zip 97701 (2) TYPE OF WORK X New Well Deepening Conve		Tax Map Numbe	er	Lot	
Alteration (complete 2a & 10) Abandonment(cor	mplete 5a)	Long°	" or		DMS or DD
(2a) PRE-ALTERATION Dia + From To Gauge Stl Plstc Wld Thrd		Long		arest address	
		· · · · · · · · · · · · · · · · · · ·	ON RANCH RD		
		02903 JOHNSC	DN RANCH RD		
Material From To Amt sacks/lbs Seal:					
(3) DRILL METHOD		(10) STATIC	C WATER LEVEL		
		Existing We	ell / Pre-Alteration		2=()
Reverse Rotary Other		Completed 7	Well 2/4/2016		644
(4) PROPOSED USE X Domestic Irrigation Community			Flowing Artesian?	Dry Hole?	
Industrial/ Commericial Livestock Dewatering		WATED BEADI	NG ZONES Depth wat	ter was first found	648 00
Thermal Injection Other			1	-	
		SWL Date	From To Est	Flow SWL(psi)	+ $SWL(ft)$
(5) BORE HOLE CONSTRUCTION Special Standard (A	ttach copy)	2/4/2016	648 752	30	644
Depth of Completed Well 752.00 ft.					
BORE HOLE SEAL	sacks/				
Dia From To Material From To Ar	mt lbs				
	52 S				
8 78 752 Calculated 50).37				
		(11) WELL I			
			Ground Elevation	۱	
How was seal placed: Method A B C D	Е		Material	From	То
Other POURED DRY		TOP SOIL		0	11
Backfill placed from ft. to ft. Material		HARD GRAY I		11	31
Filter pack from ft. to ft. MaterialSize		BROKEN BRO		31	32
Explosives used: Yes Type Amount		HARD GRAY I		32	43
		BROKEN BRO		43	46
(5a) ABANDONMENT USING UNHYDRATED BENTONIT	ГE	HARD GRAY I		46	55
Proposed Amount Actual Amount		BROKEN BRO		55	58
(6) CASING/LINER		HARD GRAY I		58	102
Casing Liner Dia + From To Gauge Stl Plstc V		RED CINDERS		102	107 159
\bigcirc 6 \times 2 752 .188 \bigcirc \bigcirc	X	BROKEN BRO MILD BROWN		159	167
			WN LAVA -LOST RETURNS		197
		HARD GRAY I		197	256
		BROKEN LOO		256	263
Shoe Inside Outside Other Location of shoe(s)			(SANDSTONE	263	279
Temp casing Yes Dia From To To		BROWN SANE		279	294
		HARD GRAY I		294	315
(7) PERFORATIONS/SCREENS		MILD BROWN	LAVA	315	322
Perforations Method FACTORY	_	D	~ ~ ~ ~		
Screens Type Material	Tala/	Date Started1	Comp	pleted <u>2/4/2016</u>	
Perf/ Casing/Screen Scrn/slot Slot # of Screen Liner Dia From To width length slots	Tele/ pipe size	(unbonded) W	ater Well Constructor Certific	ration	
Screen LinerDiaFromTowidthlengthslotsPerfLiner6732752.1253228	pipe size	. ,	e work I performed on the con		ng alteration or
		2	of this well is in compliance	· 1	0,
			indards. Materials used and inf		
			mowledge and belief.		
		License Numbe	T 1276 Da	te 2/9/2016	
			1270	2/9/2010	
(8) WELL TESTS: Minimum testing time is 1 hour		Signed VINC	CENT MACKEY (E-filed)		
\bigcirc Pump \bigcirc Bailer \bigcirc Air \bigcirc Flowing Ar	rtesian		centri Minterke i (E med)		
Yield gal/min Drawdown Drill stem/Pump depth Duration (ht	r)	(bonded) Water	r Well Constructor Certificati	on	
30 752 1		I accept response	sibility for the construction, de	epening, alteration	, or abandonment
		work performed	on this well during the construct	ction dates reported	above. All work
			ng this time is in compliance		
Temperature 64 °F Lab analysis Yes By		construction star	ndards. This report is true to the	e best of my knowle	edge and belief.
		License Number	r 1720 Da	te 2/9/2016	
Water quality concerns? Yes (describe below) TDS amount 228 From To Description Amount	Units			_, , , _010	
		Signed JACK	K ABBAS (E-filed)		
			otional) JACK ABBAS		
		· · · · ·	·		

ORIGINAL - WATER RESOURCES DEPARTMENT THIS REPORT MUST BE SUBMITTED TO THE WATER RESOURCES DEPARTMENT WITHIN 30 DAYS OF COMPLETION OF WORK Form Version:

WATER SUPPLY WELL REPORT -

continuation page

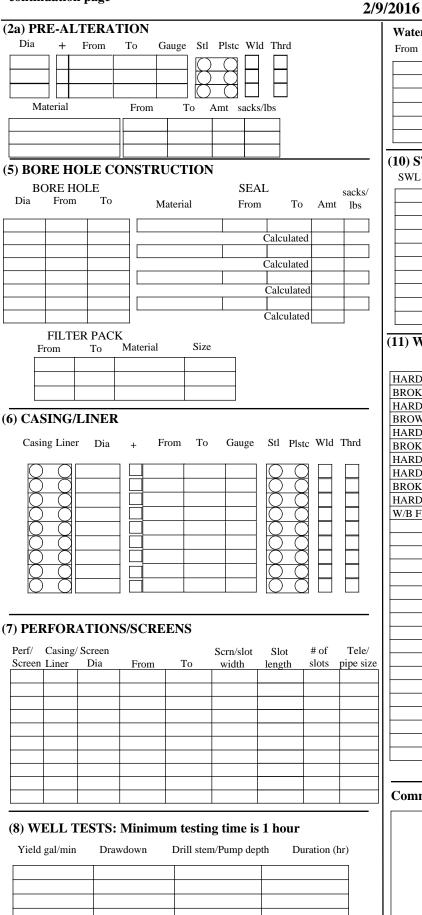

WELL I.D. LABEL# L 121557 START CARD # 1028947

Page 2 of 2

ORIGINAL LOG

Water Quality Concerns

DESC 60493

From	То	Description	Amount	Units

(10) STATIC WATER LEVEL

SWL Date	From	То	Est Flow	SWL(psi)	+	SWL(ft)
	I		I			

(11) WELL LOG

Material	From	То
HARD LAVA	322	355
BROKEN BROWN LAVA	355	361
HARD BROWN LAVA	361	402
BROWN SANDSTONE	402	428
HARD BROWN LAVA	428	455
BROKEN BROWN LAVA	455	457
HARD BROWN LAVA	457	502
HARD GRAY LAVA	502	525
BROKEN BROWN LAVA	525	527
HARD GRAY LAVA	527	648
W/B FRACTURED LAVA W/BLACK RED CINDE	648	752
		L]

Comments/Remarks