


WATER SUPPLY WELL REPORT - Map with location identified must be attached and shall include an approximate scale and north arrow

DESC 62194

8/23/2020

Map of Hole

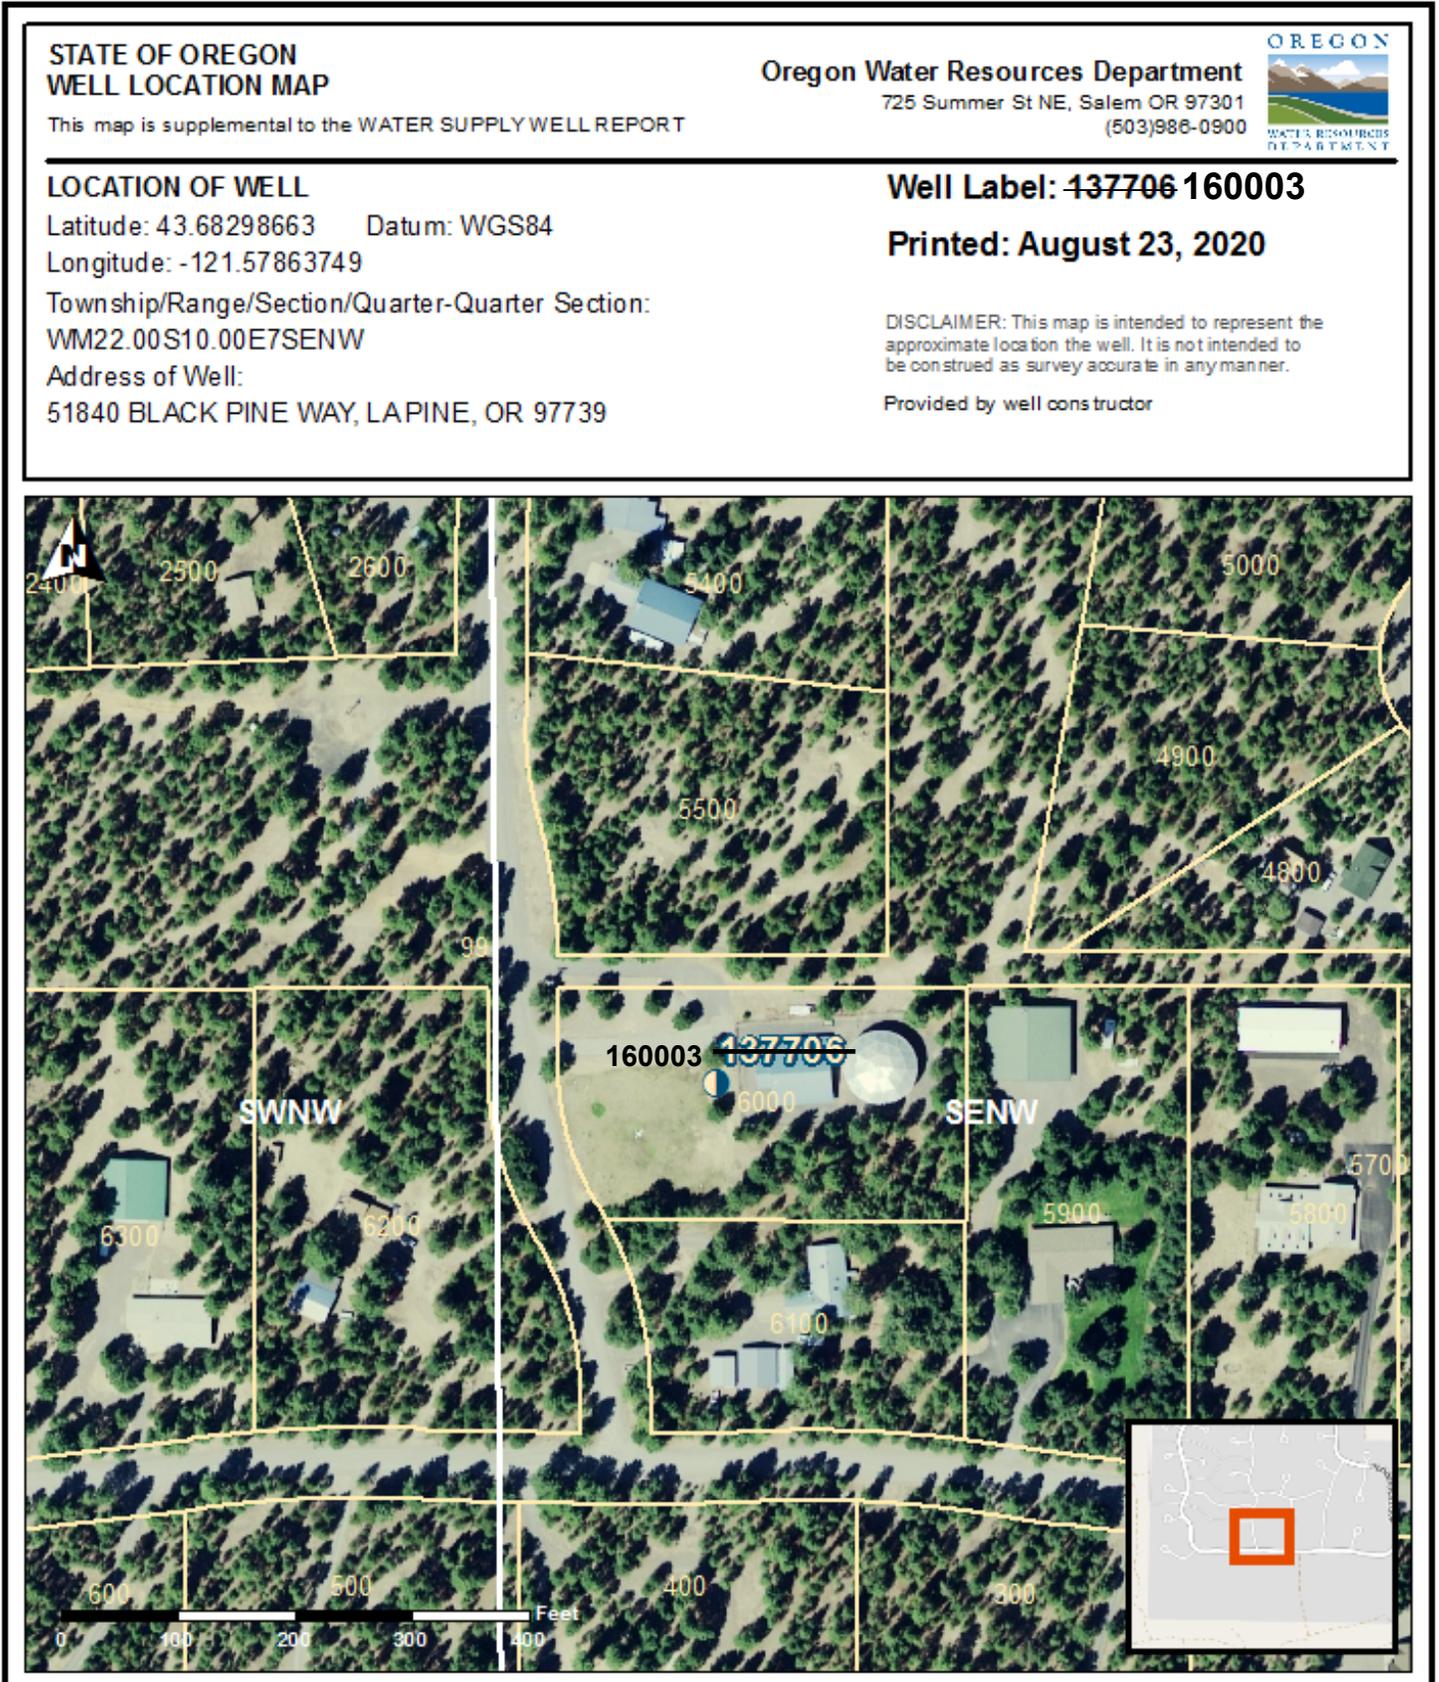



Oregon Water Resources Department
 725 Summer Street NE, Suite A
 Salem Oregon 97301
 (503) 986-0900
 www.oregon.gov/owrd

Application for Well ID Number

RECEIVED

JAN 8 2026

OWRD

Do not complete if the well already has a Well Identification Number.

I. OWNER INFORMATION

Current Owner Name (please print): Ponderosa Pines Water Company

Mailing Address: 53299 Ponderosa Way

City, State, Zip: La Pine, Oregon 97739

Mail Well ID to: SAME AS ABOVE In Care Of (C/O)

Name & Address: _____

City, State, Zip: _____

II. WELL LOCATION INFORMATION (Please fill out as completely as possible)

Township: 22S (North / South) Range: 10E (East / West) Section: 7 SE 1/4 of the NW 1/4

Tax Lot (usually last 3-5 numbers of Tax Map #): 6000 County Deschutes

GPS Coordinates: 43.68296821771015, -121.57862161579123

Street Address of Well, City: 51840 Black Pine Way

If the property had a different street address in the past: _____

III. GENERAL WELL INFORMATION (Please fill out as completely as possible, AND attach copy of Well Report, if available)

Use of Well (domestic, irrigation, commercial, industrial, monitoring): Domestic

Date Well Constructed (or property built): 6/18/2020 Total Well Depth: 410' Casing Diameter: 10"

Owner at time the well was constructed (if known): Ponderosa Pines Water Well Report # (if known): Desc 62194

Other Information: well ID tag L 137706 is lost

SUBMITTED BY (please print): David Trachsel

PHONE: (760) 936-1870 EMAIL &/or FAX: ppwcpresident@gmail.com

To send the completed application, you may MAIL it to: Oregon Water Resources Dept. 725 Summer St NE, Suite A, Salem, Oregon 97301.
 Or EMAIL the completed PDF form to: Ladeena.K.Ashley@water.oregon.gov, or FAX it to: (503) 986-0902.

****REPLACEMENT WELL ID****

For Official Use Only by the Oregon Water Resources Department:

Received Date:

1-8-2026

Well Report Number:

DESC 62194

Well Identification #:

L-160003